

Dig Safely. New York
 Underground Facilities Protective Organization
800-962-7962
 www.digsafelynewyork.org

Call Before You Dig
 Wait The Required Time
 Confirm Utility Response
 Respect the Marks
 Dig With Care


CONSTRUCTION NOTES

ALL WORK SHALL BE ACCOMPLISHED ACCORDING TO THE PLANS AND SPECIFICATIONS OF THE PROJECT. ANY CHANGES SHALL BE WITH PRIOR WRITTEN APPROVAL BY THE ENGINEER AND/OR CONTRACTING OFFICER.

AT LEAST TWO FULL WORKING DAYS PRIOR TO EXCAVATION, THE CONTRACTOR SHALL NOTIFY THE UNDERGROUND FACILITIES PROTECTION ORGANIZATION (U.F.P.O.) AT 1-800-962-7962 AND ANY OTHER LOCAL UTILITIES THAT MAY BE IN THE AREA.

THE CONTRACTOR SHALL GIVE THE DCSCWD AND THE LANDOWNER/OPERATOR A MINIMUM OF TWO FULL WORKING DAYS NOTICE PRIOR TO CONSTRUCTION.

ALL CONSTRUCTION PRACTICES SHALL BE IN ACCORDANCE WITH O.S.H.A. STANDARDS AND REGULATIONS PART 1910 AND 1926. ALL TRENCH EXCAVATIONS IN UNSTABLE SOILS OR IN TRENCHES GREATER THAN FIVE FEET DEEP SHALL BE SLOPED, SHORED, OR SHIELDED ACCORDING TO O.S.H.A. PART 1926.

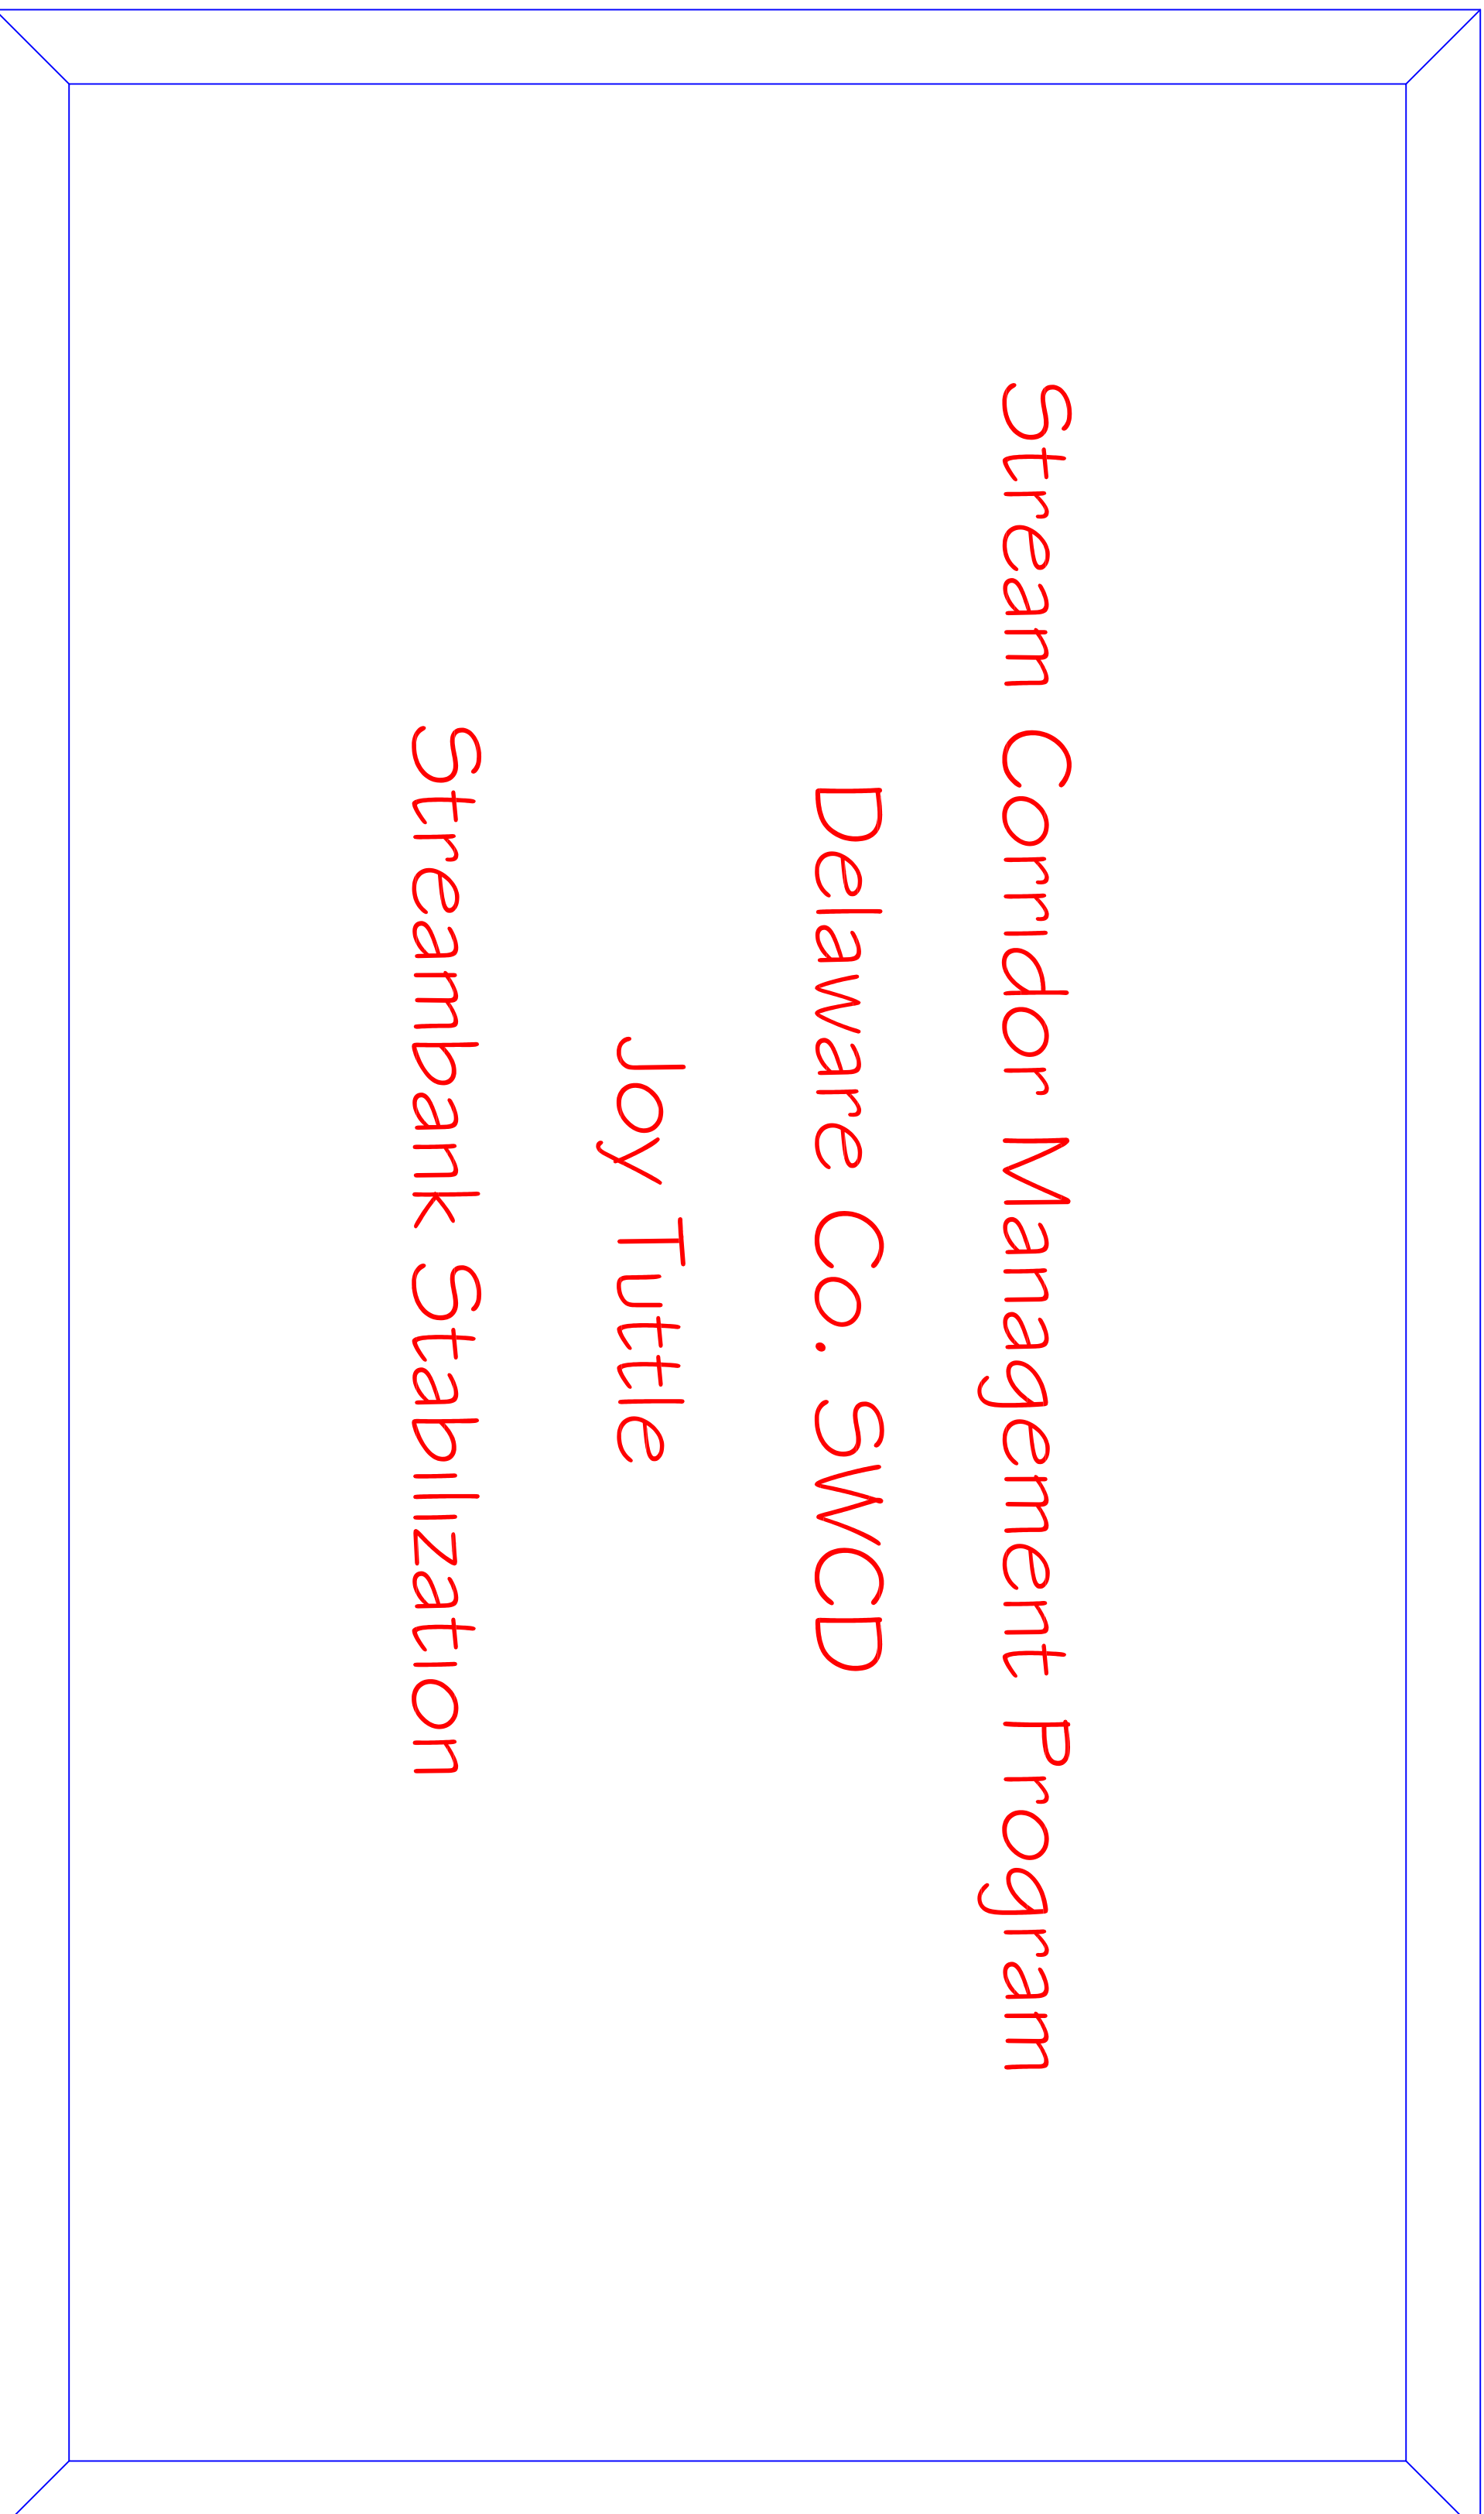


Stream Corridor Management Program
 Delaware Co. SWCD
 Joy Tuttle
 Streambank Stabilization

CONTENTS

- Sheet 1 : Title Sheet
- Sheet 2 : Existing Plan View
- Sheet 3 : Proposed Plan View and Details
- Sheet 4 : Cross Sections - Sta 3+00 to 5+00
- Sheet 5 : Cross Sections - Sta 5+50 to 6+50

I HAVE REVIEWED THE DRAWINGS AND SPECIFICATIONS FOR THIS PROJECT. THE PROJECT HAS BEEN EXPLAINED TO ME FULLY, AND I AGREE WITH ALL TECHNICAL ASPECTS OF THE PROJECT.

LANDOWNERS SIGNATURE: _____ DATE: _____

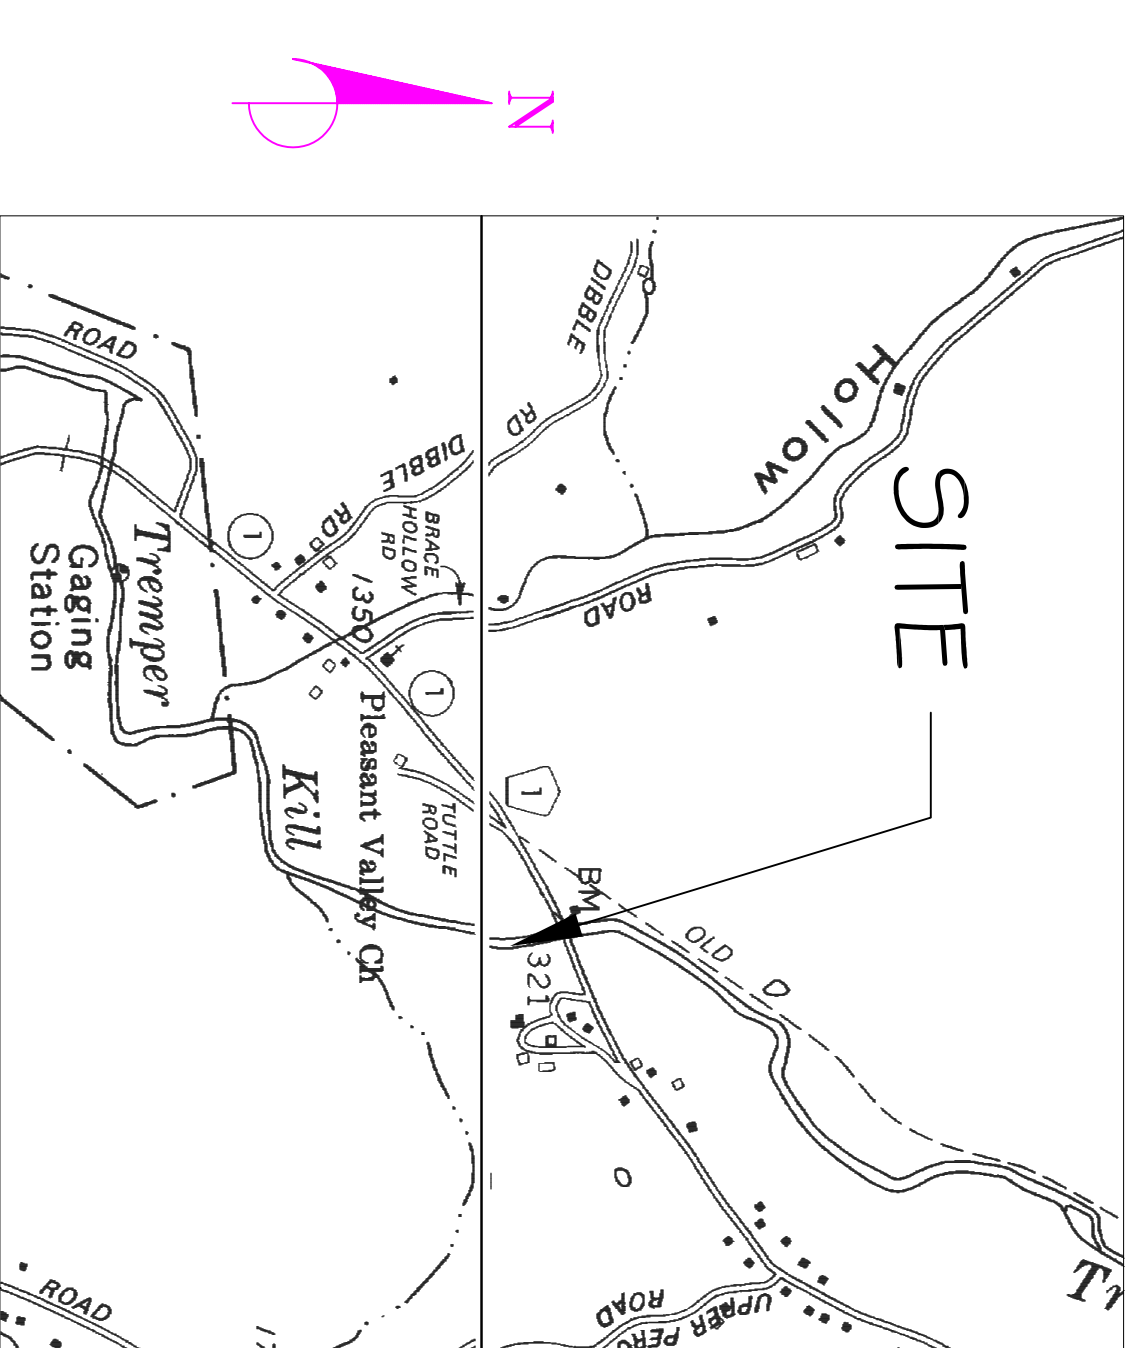

SITE MAP

A5-Built



Joy Tuttle

Streambank Stabilization


Delaware Co. Stream Corridor Management Program
 Delaware Co., NY



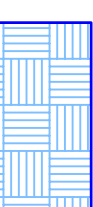

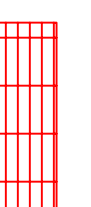
Delaware County Soil & Water Conservation District
 44 West Street
 Walton, NY 13856




Designed	Date	Approved by	
Drawn G. Neale	3-28-07	Title	
Traced		Sheet No.	DEP-SCMP-002
Checked		of	5

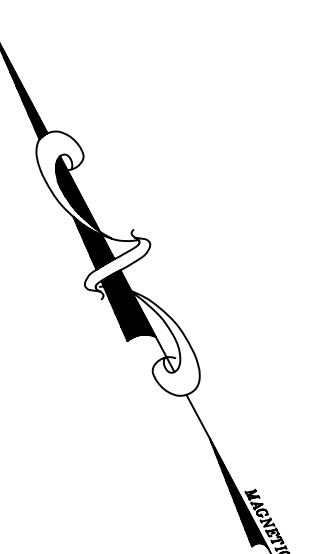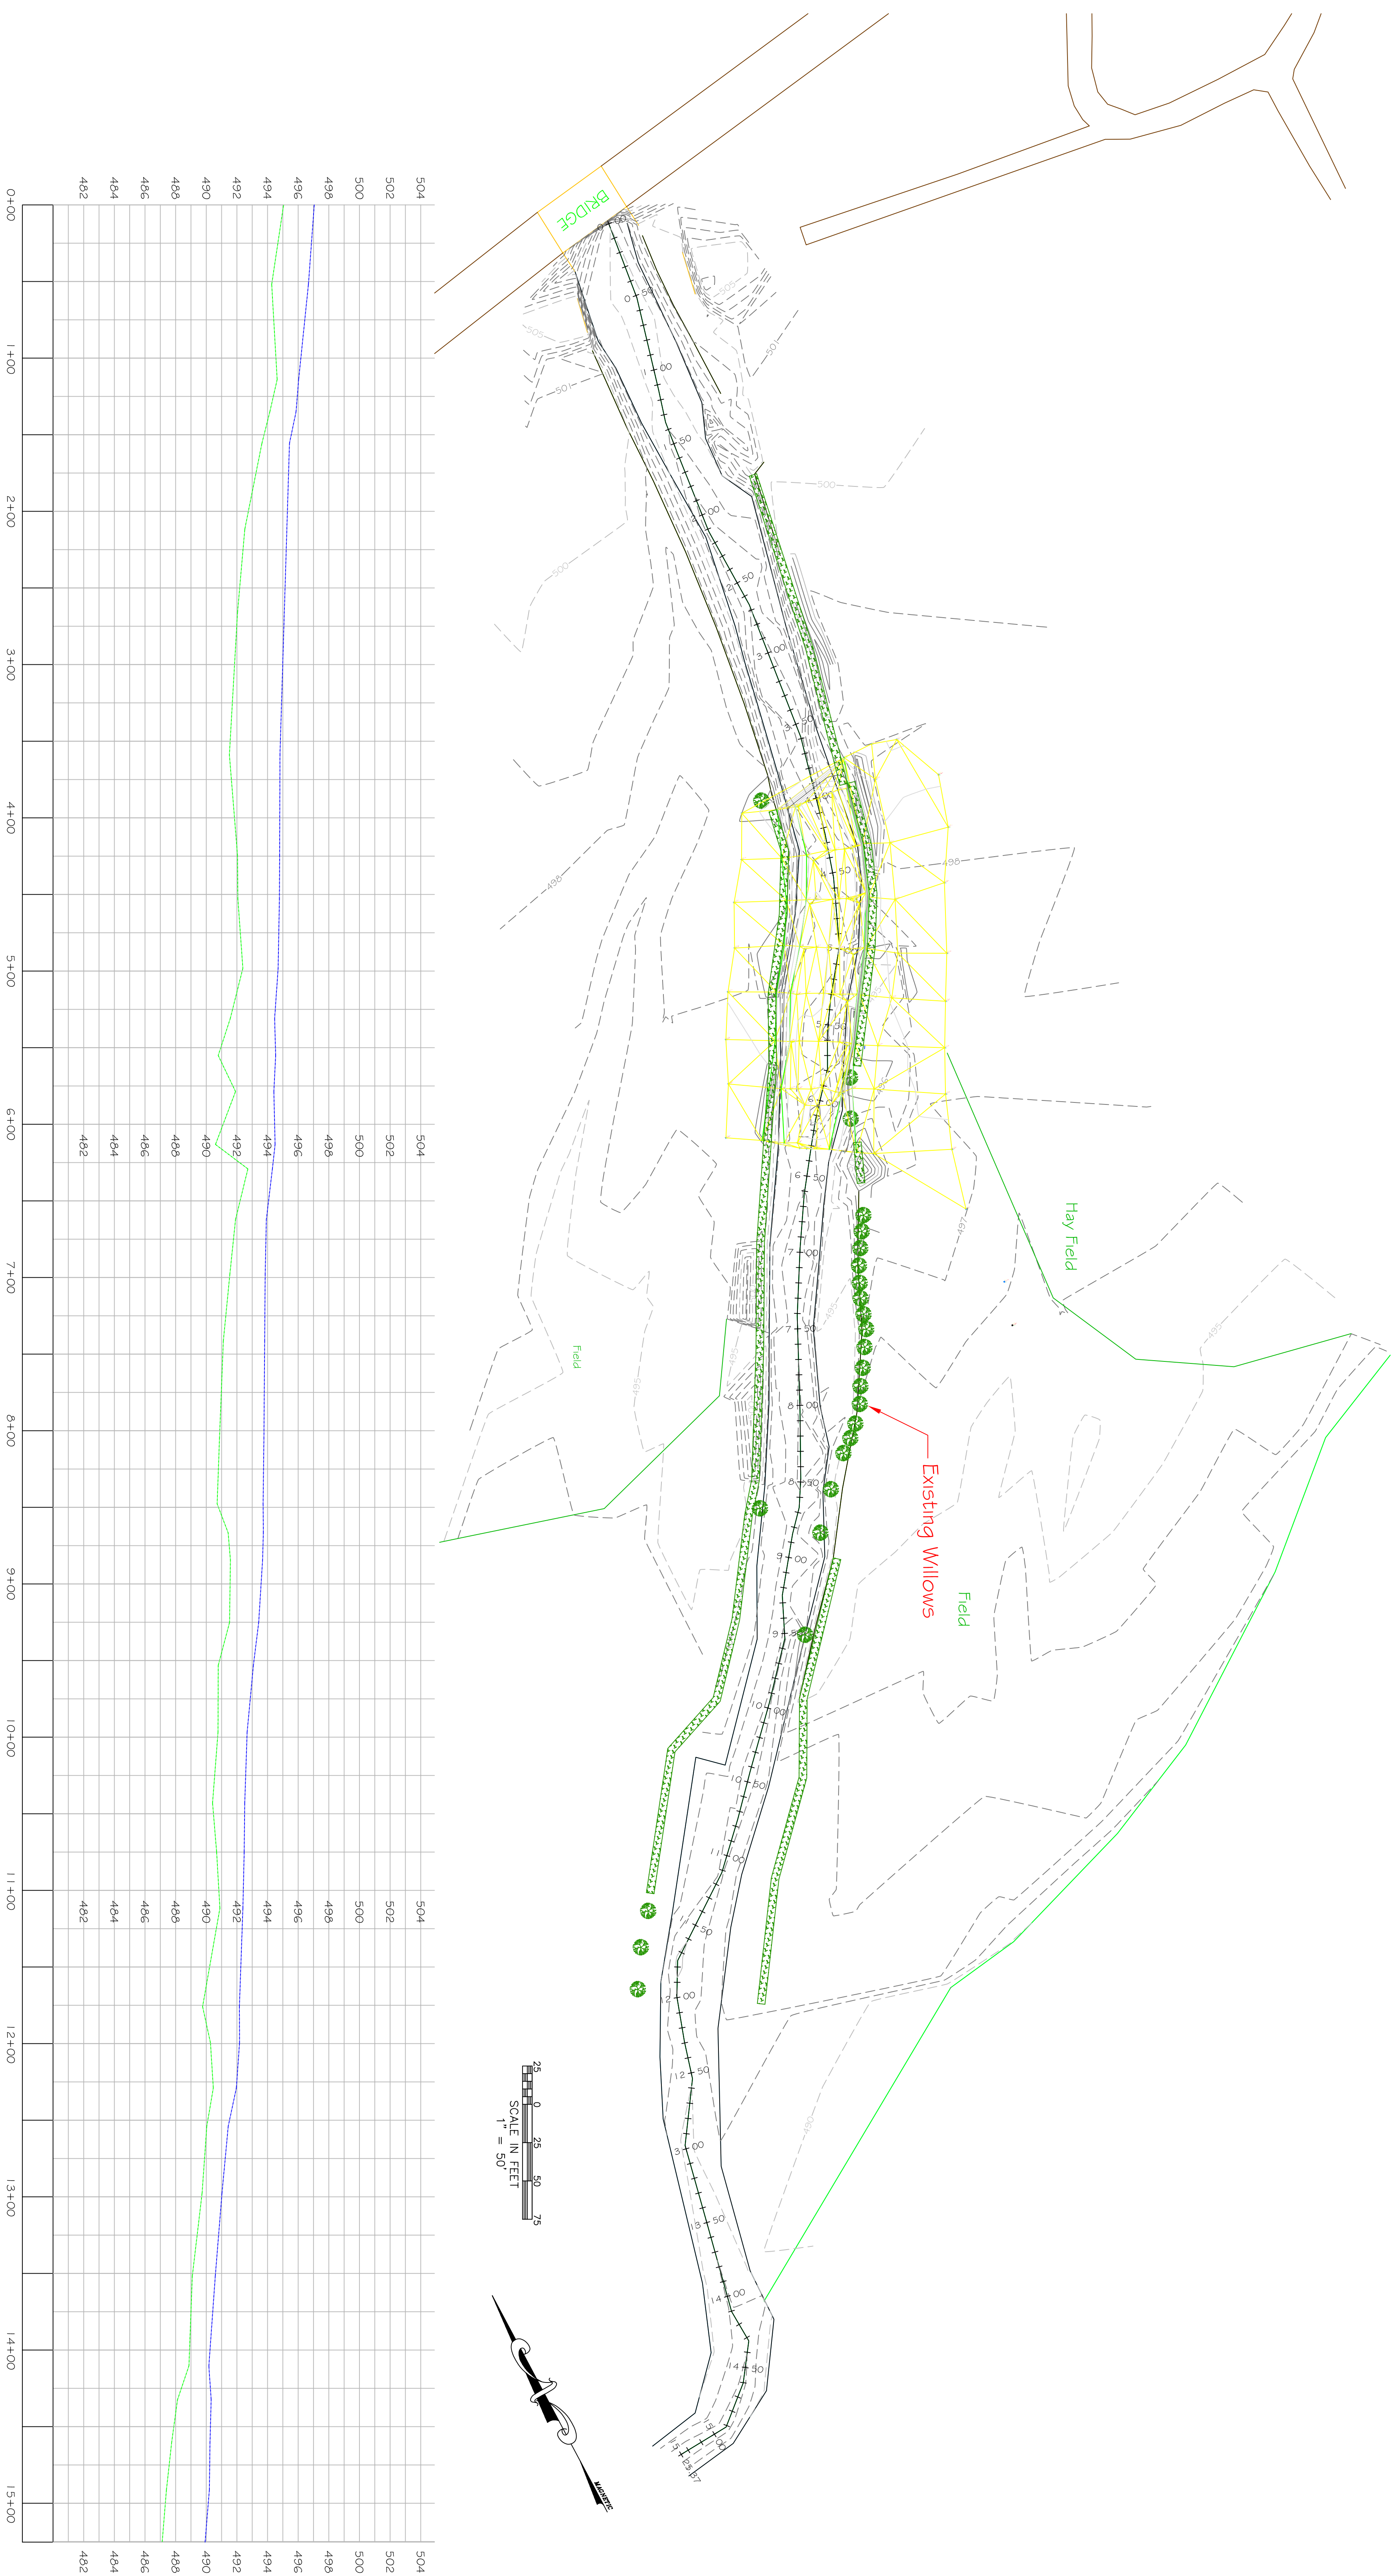

<p>Joy Tuttle Streambank Stabilization Existing Plan View</p>	
<p>Delaware Co. Stream Corridor Management Program Delaware Co., NY</p>	
<p>Delaware County Soil & Water Conservation District 44 West Street Walton, NY 13856</p>	
Designed by	Thomas J. Malloy
Date	03-27-2007
Drawn by	G. Neale
Title	
Checked by	S. Gladstone
Date	03-27-2007
Sheet No. 2	of 3
Drawing No.	DEP-SCMP-002

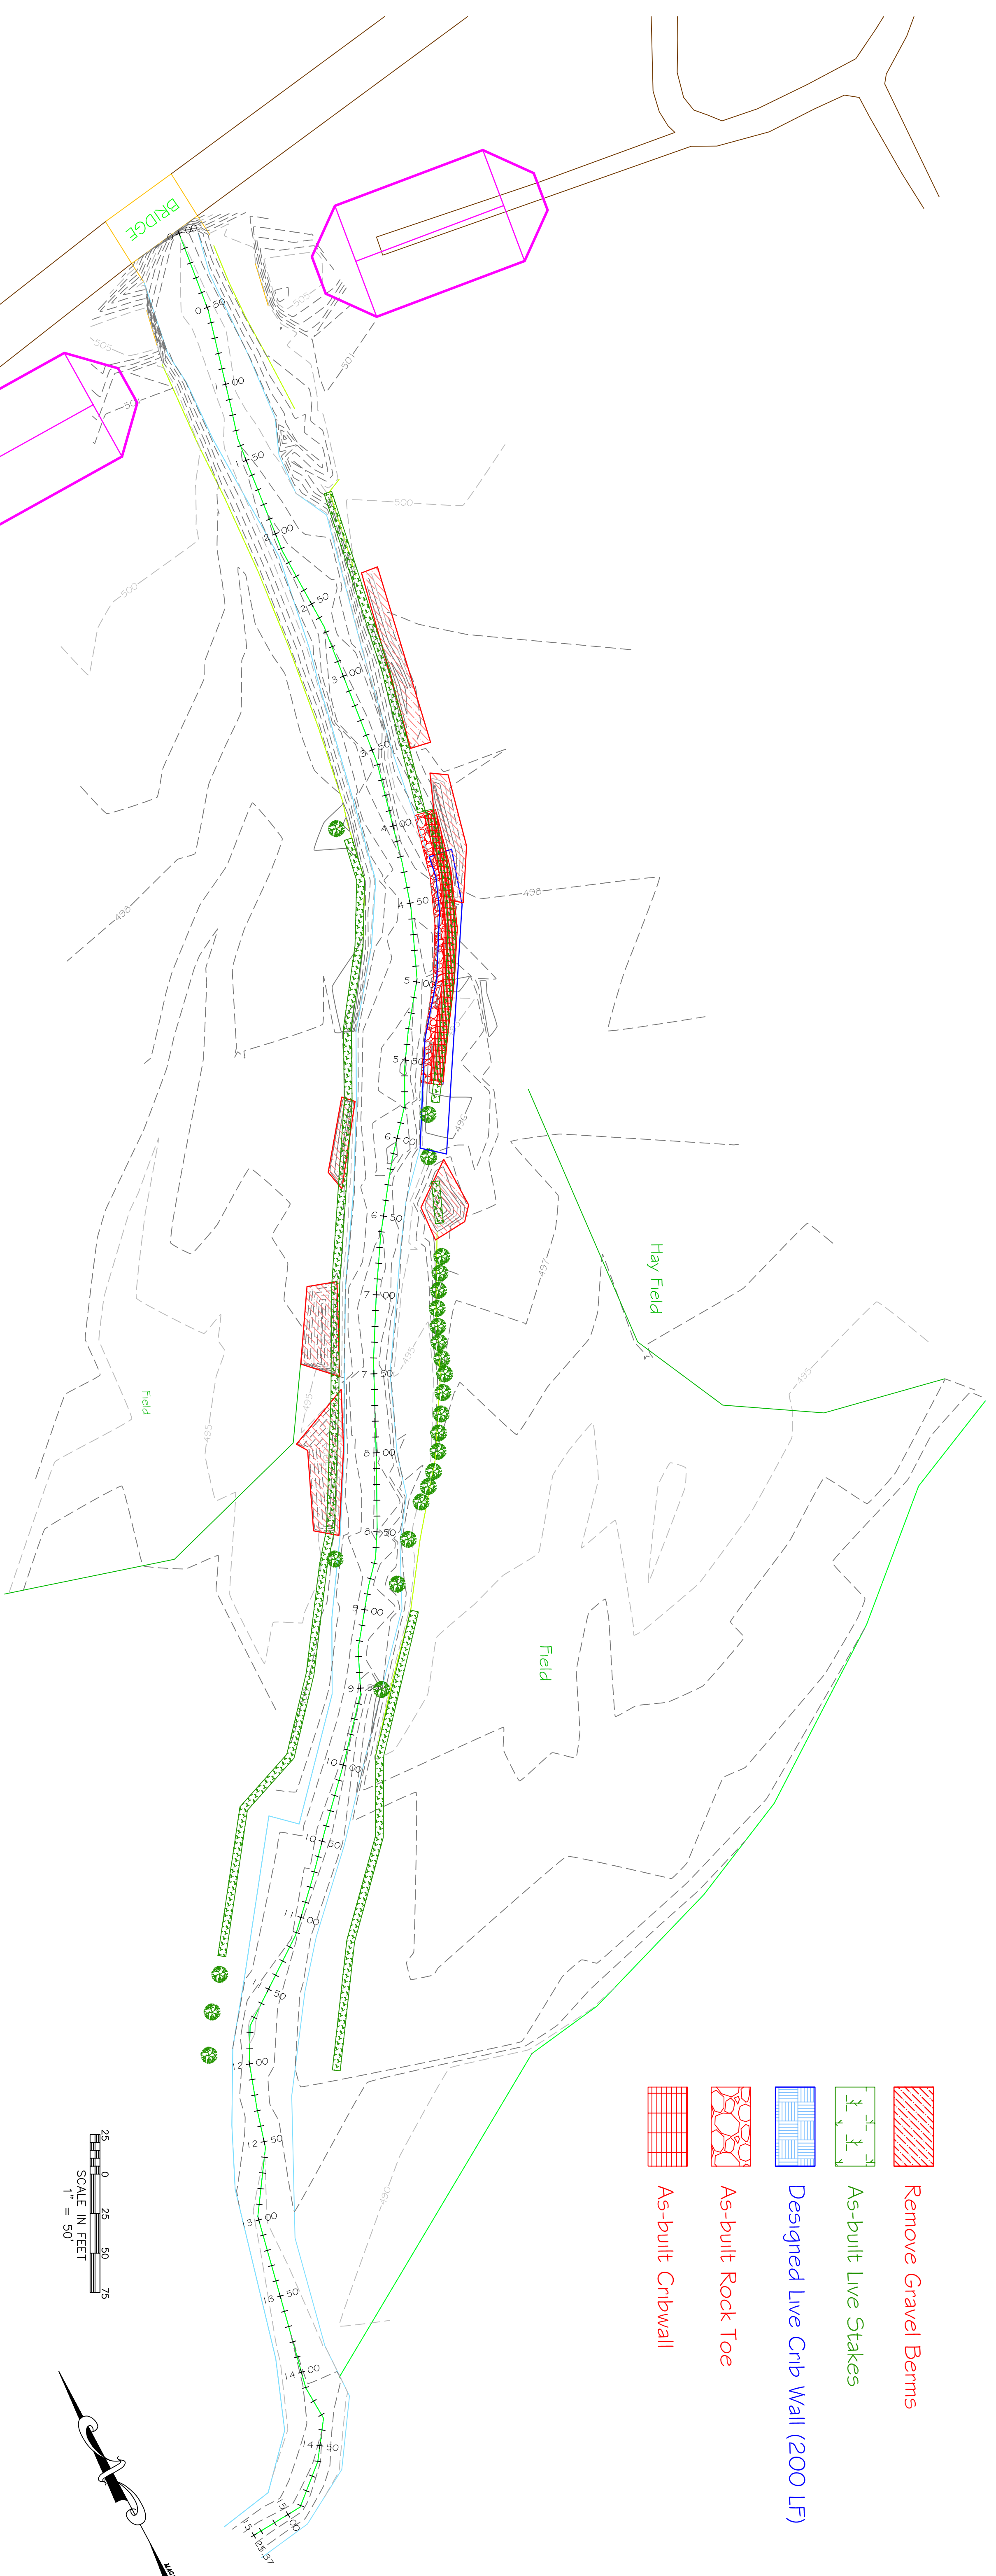


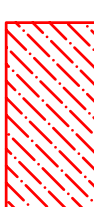-  Remove Gravel Berms
-  As-built Live Stakes
-  Designed Live Crib Wall (200 LF)
-  As-built Rock Toe
-  As-built Cribwall

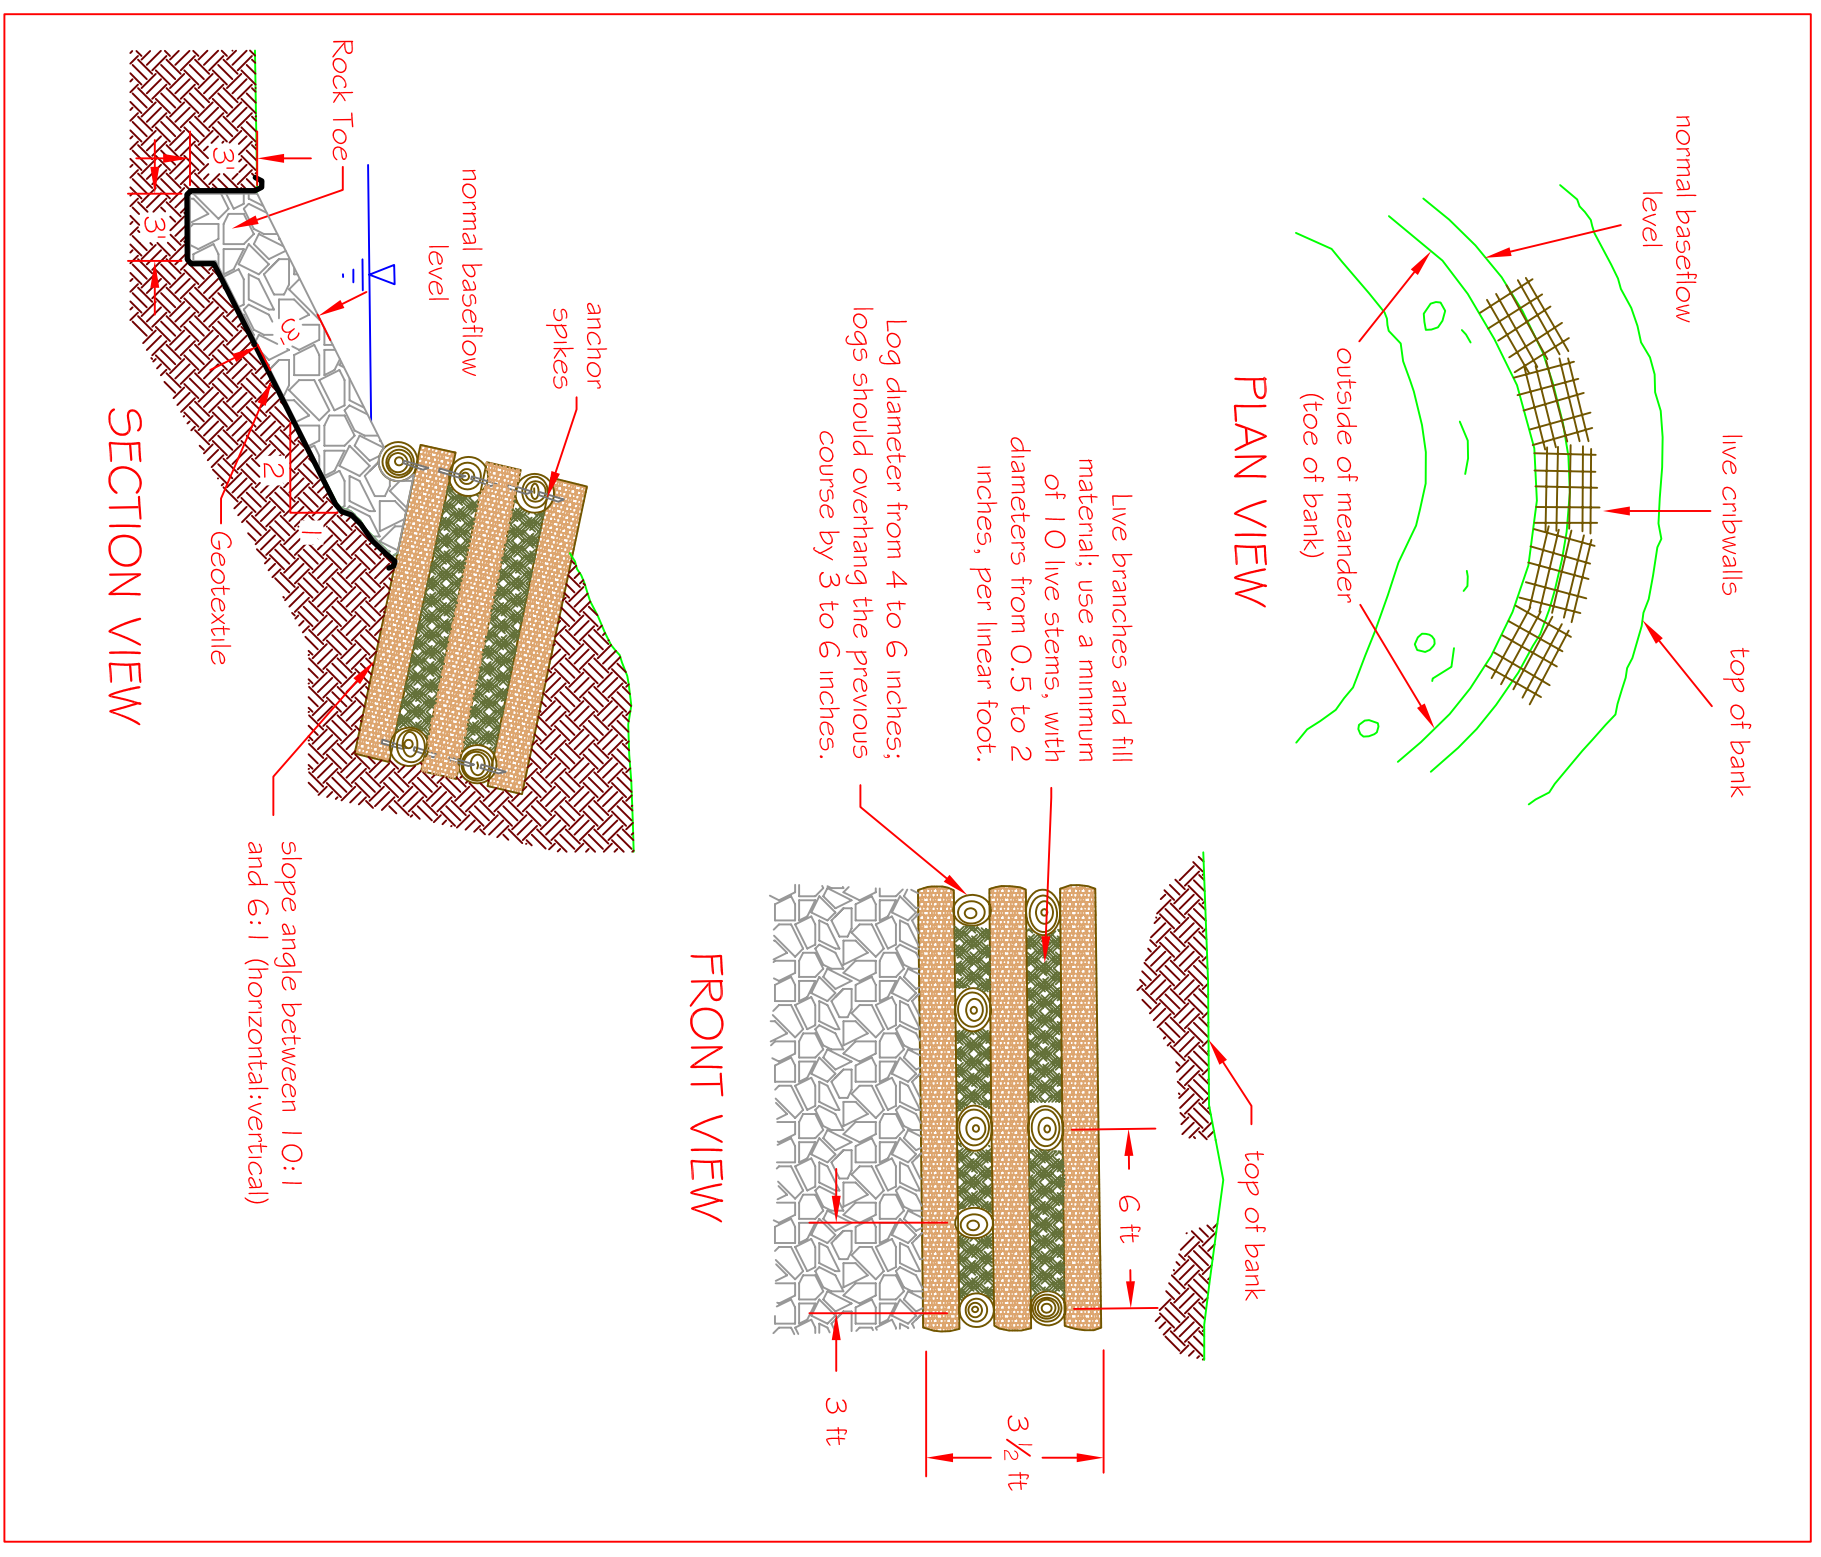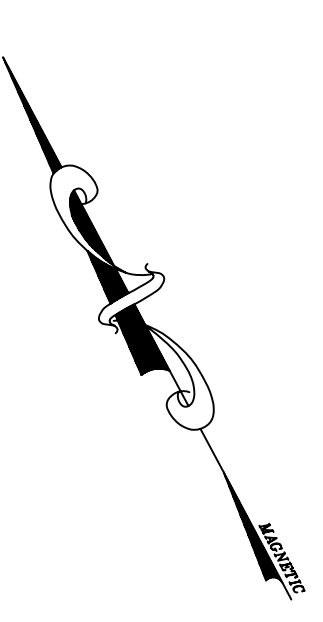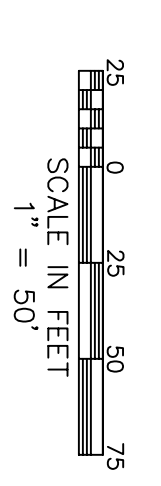

Live Stake Layout


(Not to Scale)

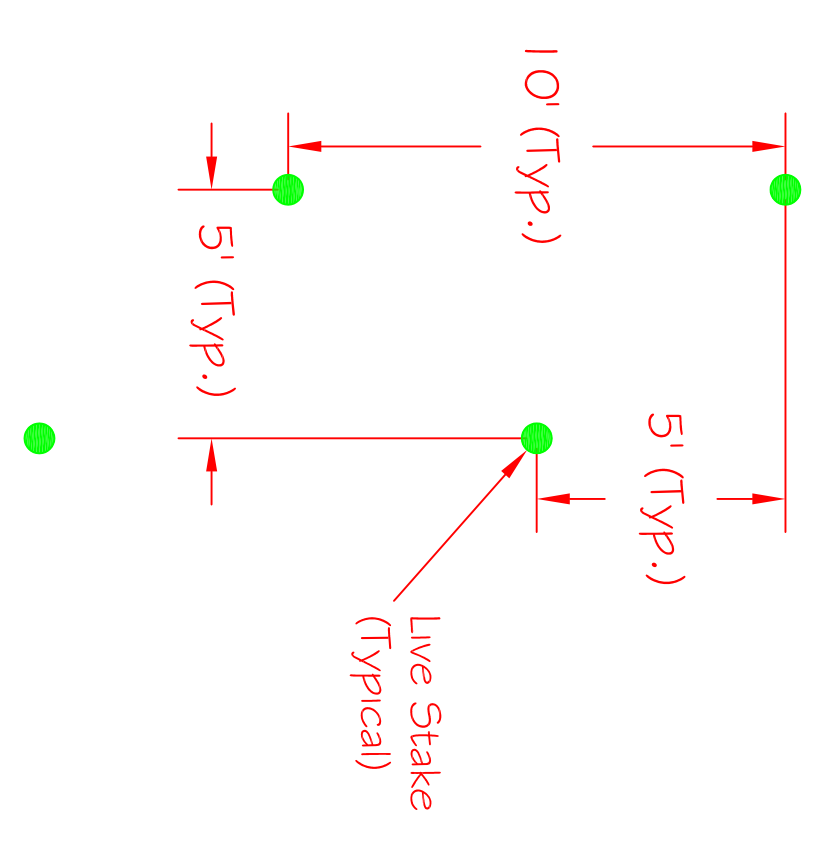

D:\land Project R3\LDT Files Stream\Typical Stream Program\LiveStake-2.dwg

Live Stake Detail





(Not to scale)

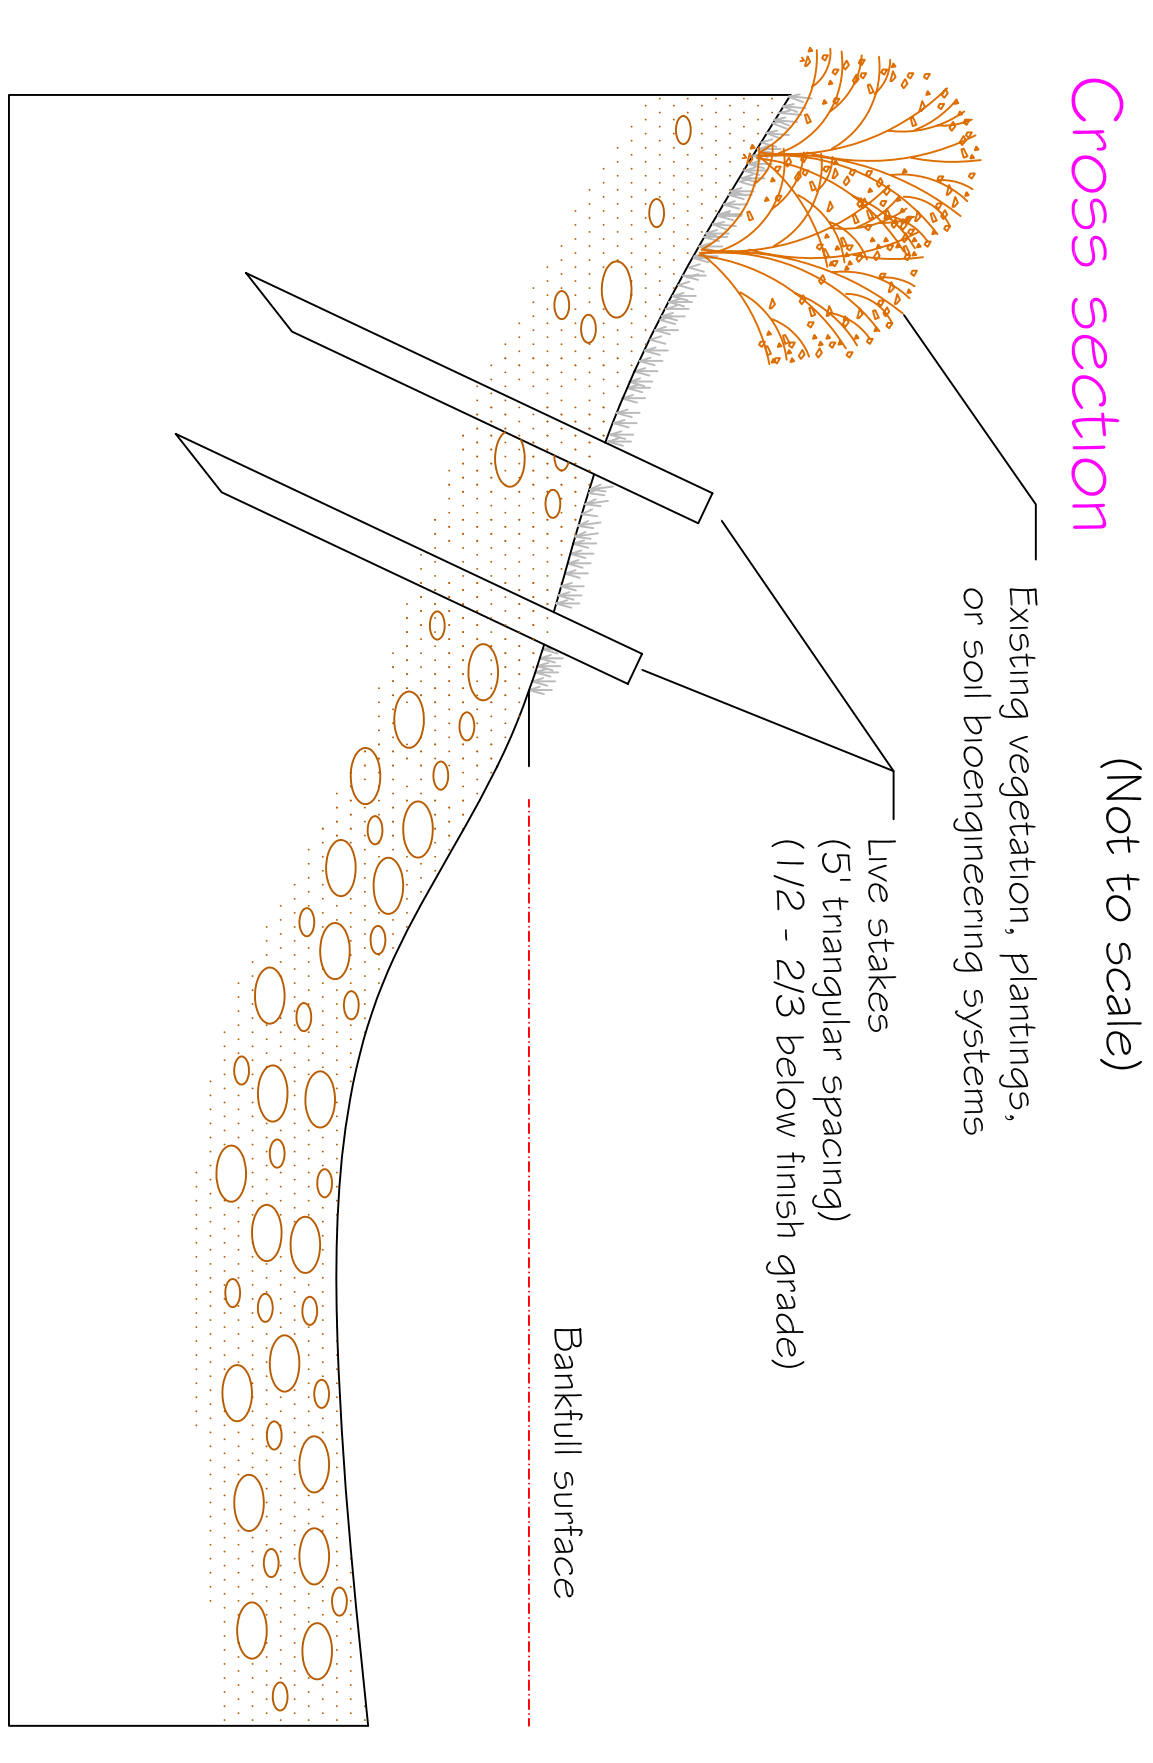

D:\land Project R3\LDT Files Stream\TypicalStream Program\LiveStakeDetail.dwg

As-Built

Joy Tuttle Streambank Stabilization Proposed Plan View and Details Delaware Co. Stream Corridor Management Program Delaware Co., NY Delaware County Soil & Water Conservation District 44 West Street Watson, NY 13856	
Designed by Thomas J. Malloy	Date 12-04-2007
Drawn by J. Fisk	Title _____
Checked by S. Gladstone	Sheet No. 3 of 3
Project No. 03-27-2007	Drawing No. DEP-SCMP-002

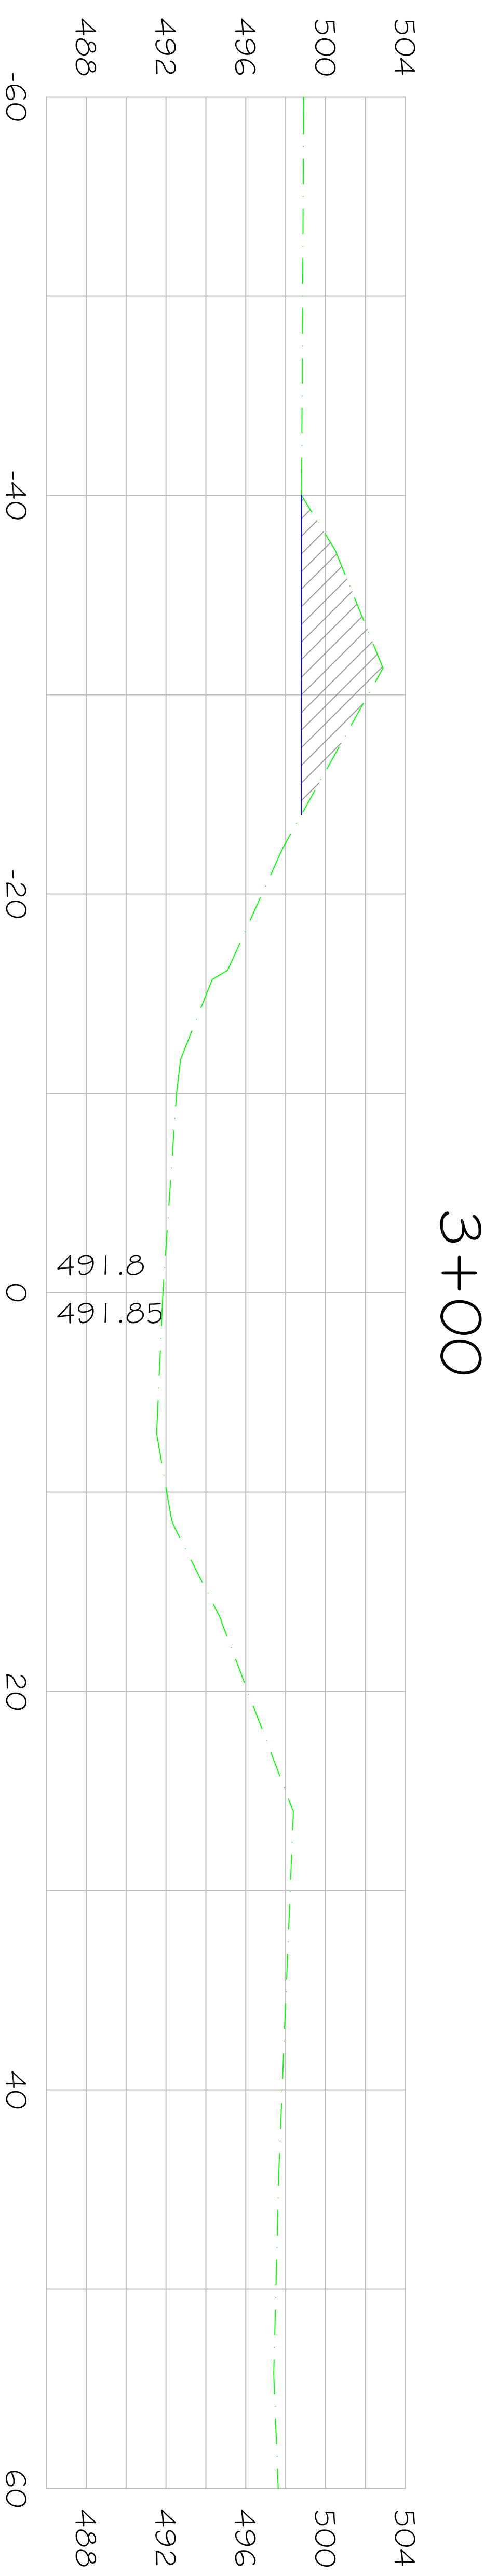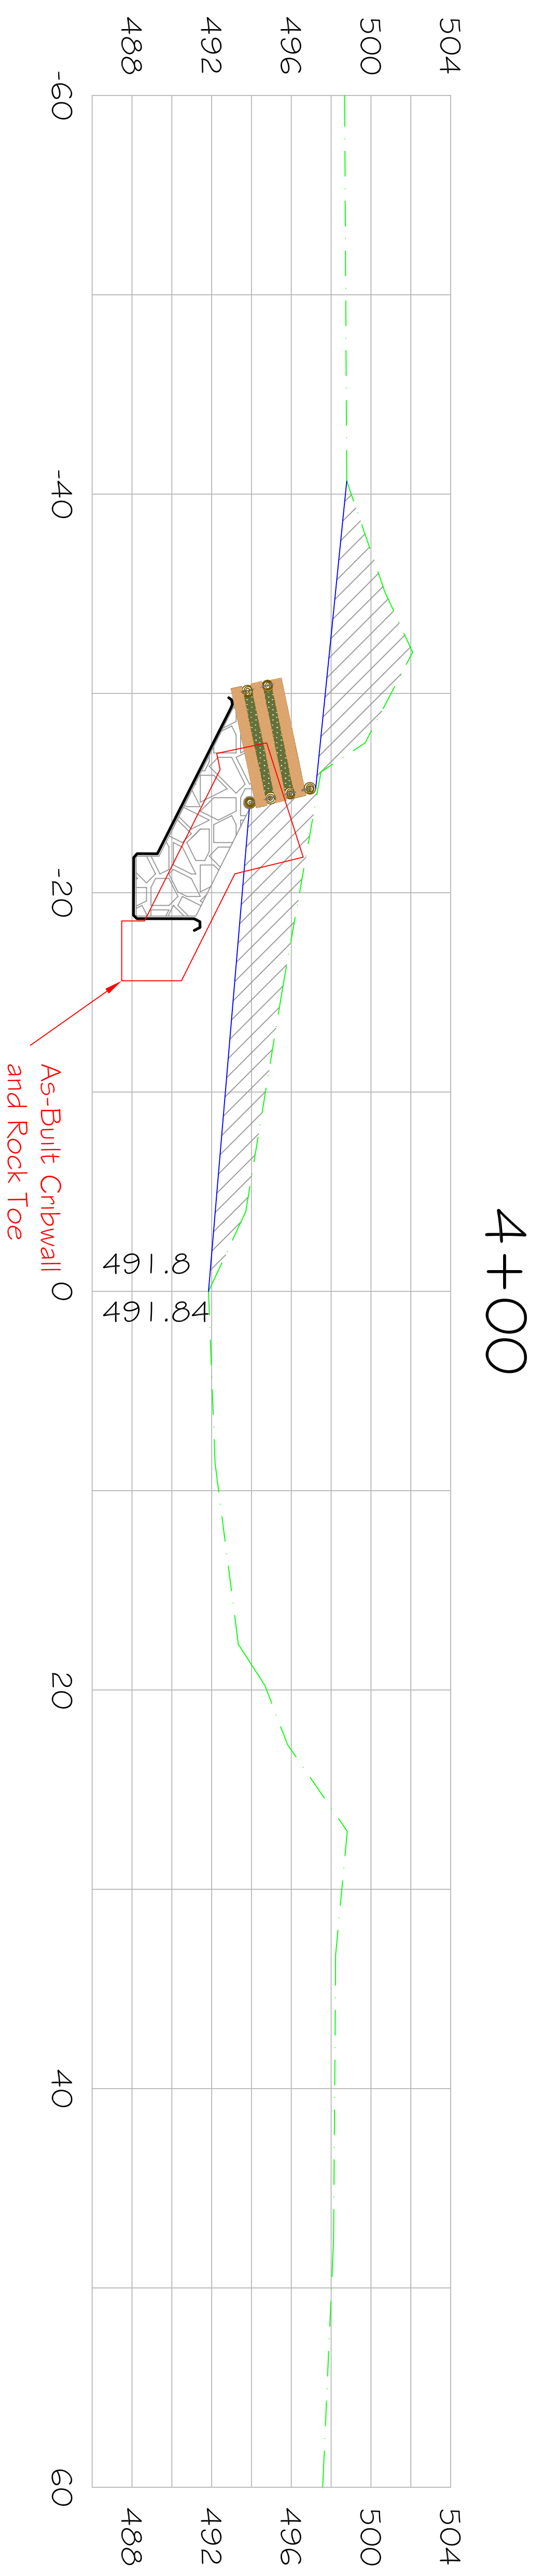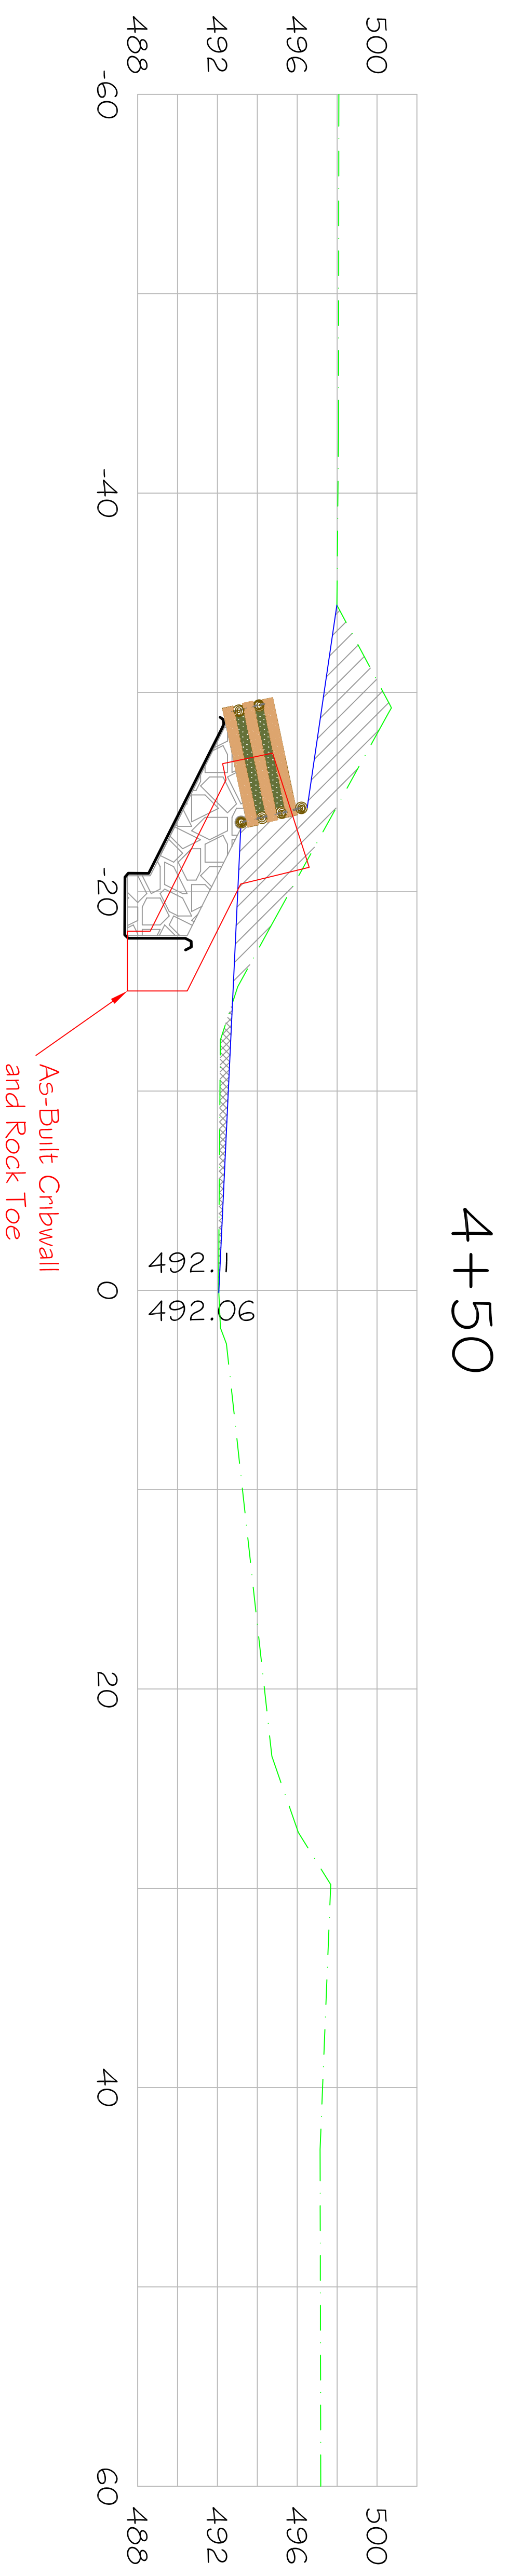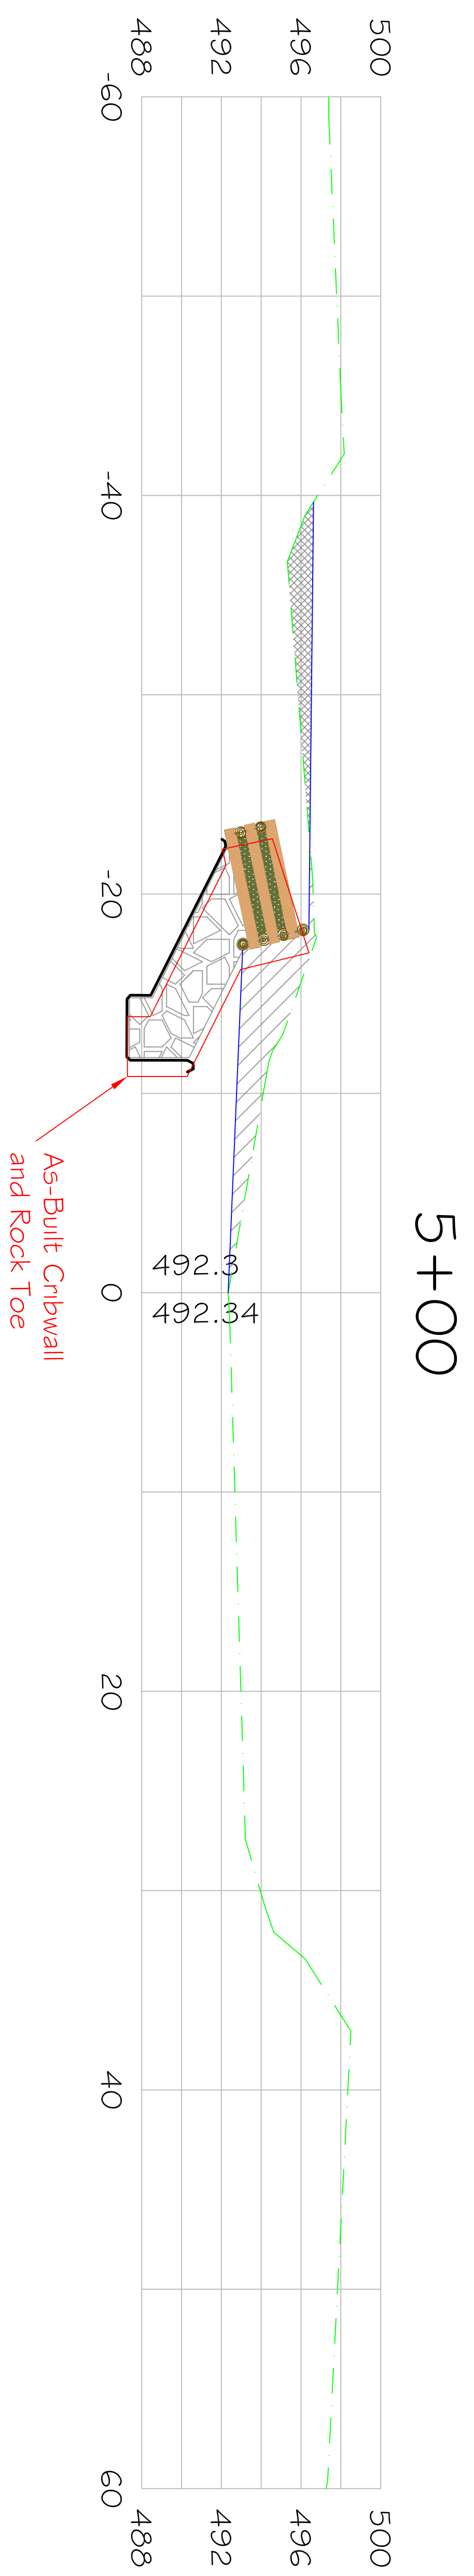

As-Built

Joy Tuttle

Streambank Stabilization

Cross Sections - Sta 3+00 to 5+00

Delaware Co. Stream Corridor Management Program

Delaware Co., NY

Delaware County Soil & Water Conservation District

44 West Street

Walton, NY 13856

Date: _____




Approved by: _____

Drawn: G. Neale 03-27-2007

Designed: Thomas J. Malloy

Checked: S. Gladstone 03-27-2007

Sheet No. 1 of 3 Drawing No. DEP-SCMP-002

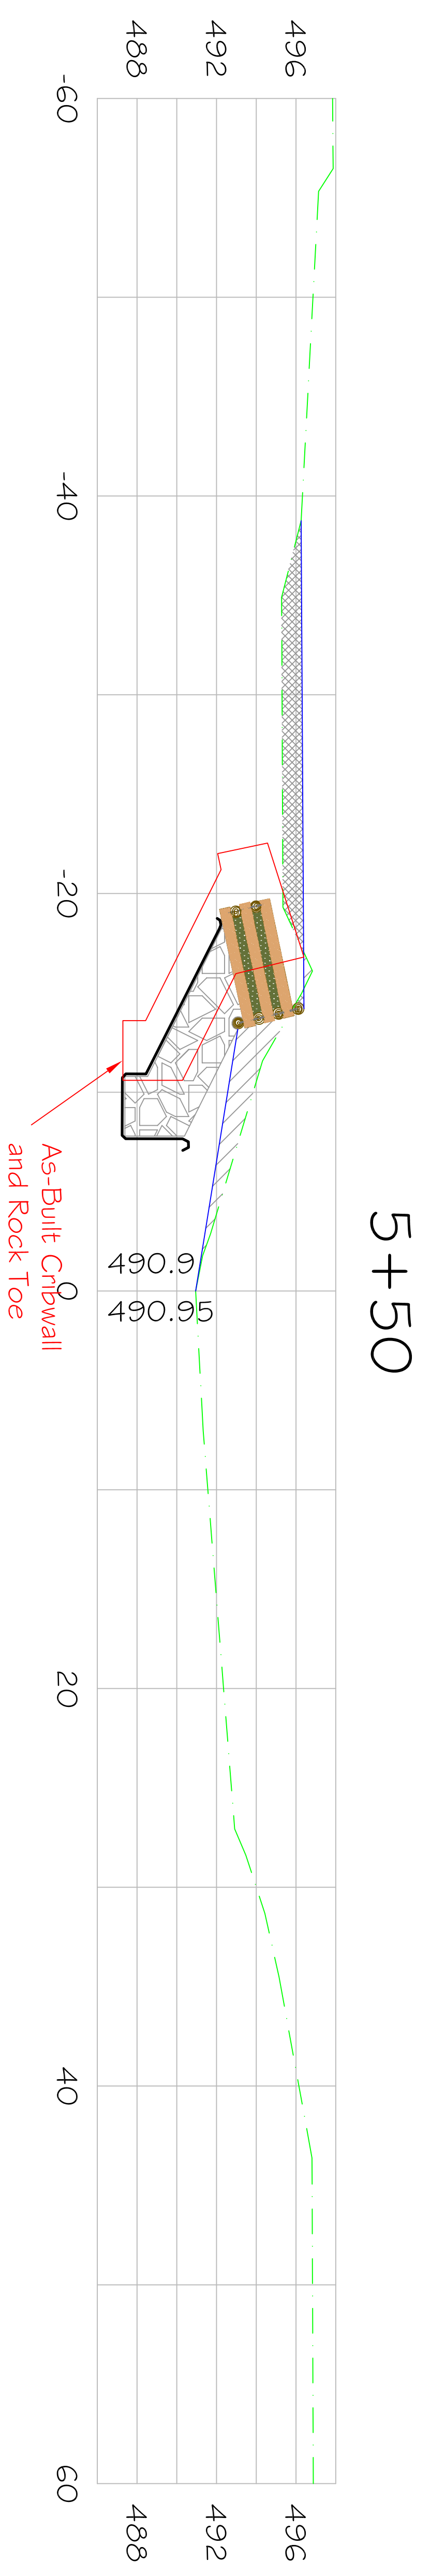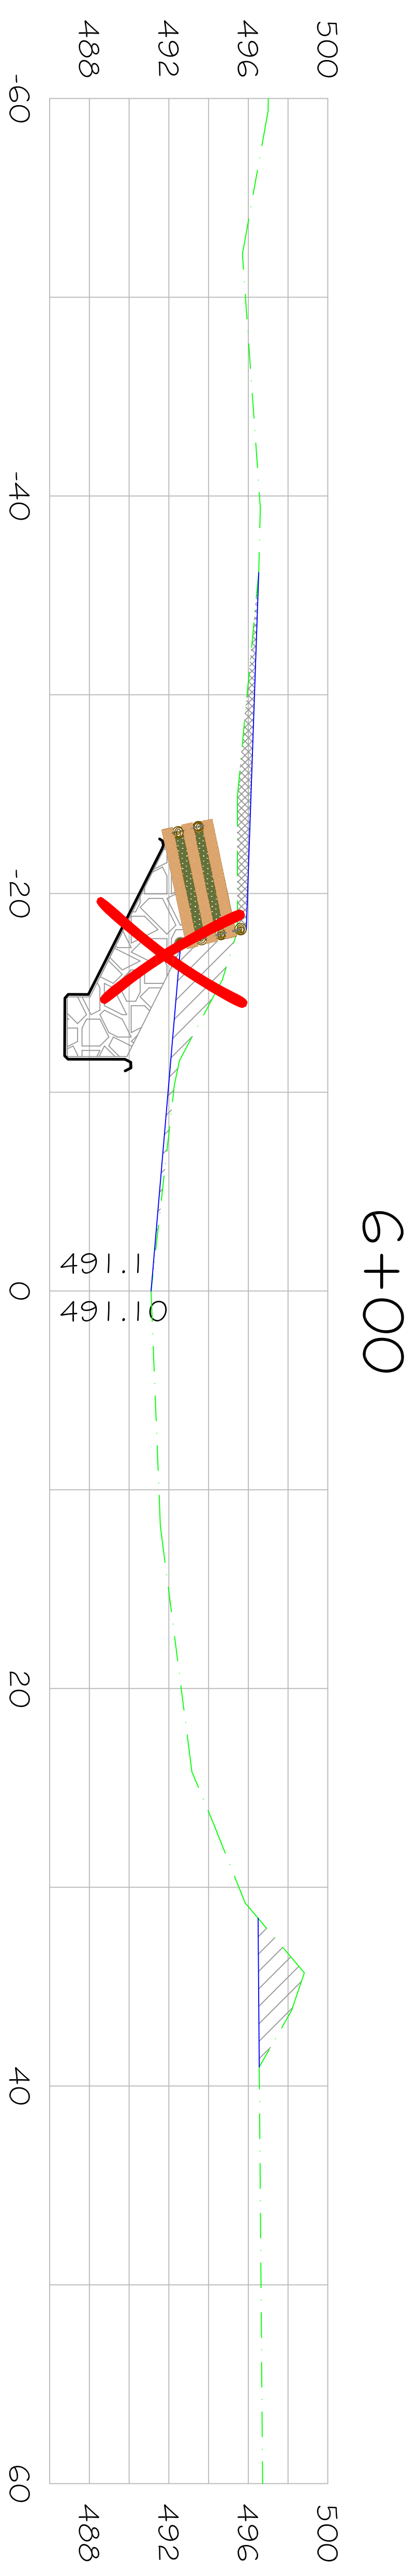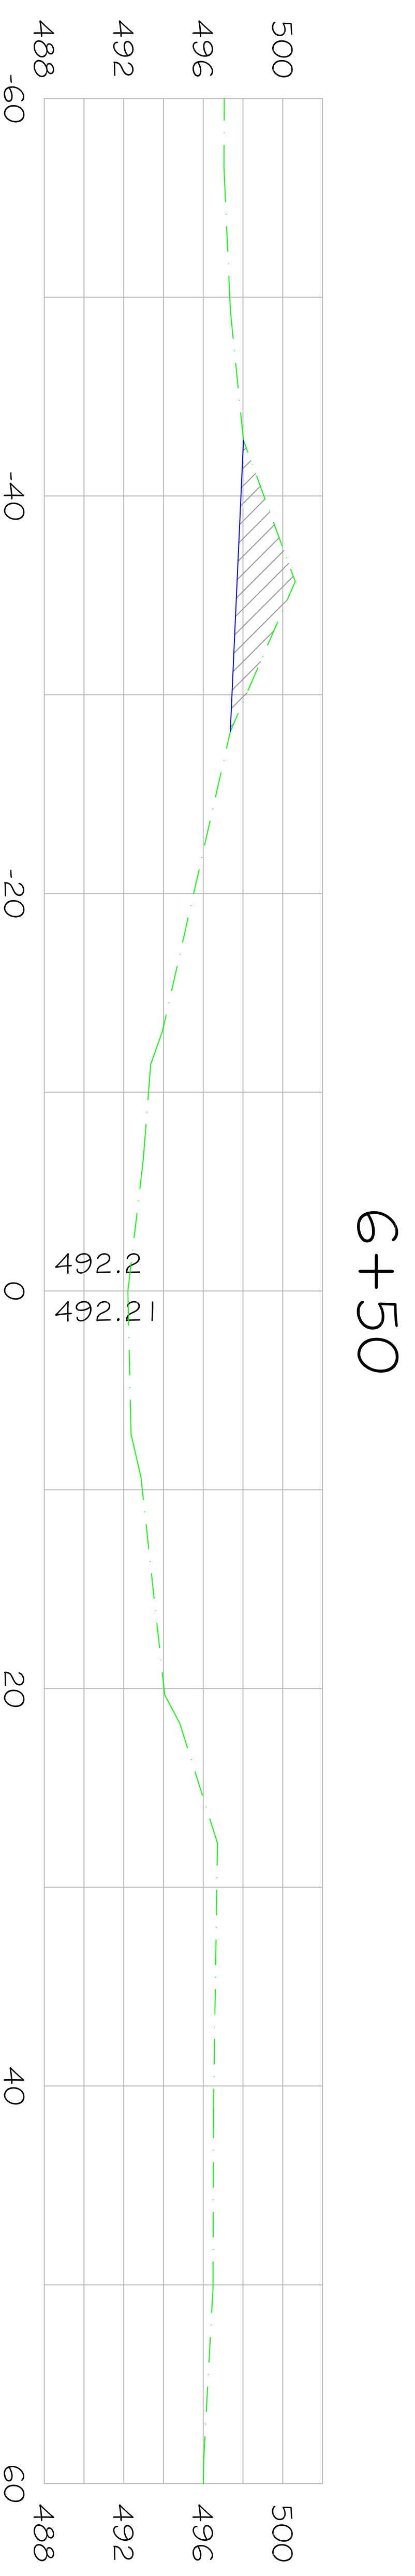

As-Built

Joy Tuttle

Streambank Stabilization

Cross Sections - Sta 5+50 to 6+50

Delaware Co. Stream Corridor Management Program

Delaware Co., NY

Delaware County Soil & Water Conservation District

44 West Street

Walton, NY 13856

Designed	Thomas J. Malloy	Date	
Drawn	G. Neale	Title	
Checked	S. Gladstone	Sheet No. 3	Drawing No. DEP-SCMP-002
		of 3	