



Final Report
for
Fish Passage Improvement
on
Town Brook

Town of Stamford

Delaware County, New York

by
Scotty Gladstone, Stream Program Coordinator
Delaware County Soil & Water Conservation District
44 West Street, Suite 1
Walton, NY 13856

Table of Contents

Project Site Description	1
Project Background	1
Project Description	2
Work Performed	2
Project Benefits	3
Conclusion	3

Attachment A - Budget

Attachment B - Maps

Attachment C - Photographs

Attachment D - As-built Project Drawings and Project Specifications - Post Farm

Attachment E - As-built Project Drawings and Project Specifications - Palmatier Farm

Project Site Description

Town Brook is located in the Town of Stamford, Delaware County, New York, and is within the New York City water supply watershed (see Maps 1-3 in Attachment B). The site is near the stream headwaters with a drainage area of 1.6 square miles. The stream here flows through two active dairy farm pastures. Both producers have buffered their respective stream reaches through the United States Department of Agriculture's Conservation Reserve Enhancement Program (CREP). (CREP pays for the installation of livestock exclusion fencing and plant materials to buffer streams flowing through agricultural lands. It also provides for annual per acre rental payments for 10-15 years).

The downstream location is readily accessible, is a public fishing stream and is currently used for education and outreach tours. The site will continue to be used for research and educational purposes. Data obtained from post-construction monitoring of both locations will be highlighted during future education and outreach events and will also be shared with those entities that will find it useful.

Project Background

In 2004 the Delaware County Soil & Water Conservation District (DCSWCD), under contract with the New York City Department of Environmental Protection (NYCDEP), constructed a full-scale demonstration stream restoration project on the downstream farm. The project consisted of stream re-alignment, establishment of adequate floodplain and installation of in-stream rock structures to maintain grade control and pool locations, and to reduce stream shear stress on the banks.

Post-project evaluations led to some concerns with fish passage at some of the rock cross-vane structures (A rock cross-vane is a U-shaped structure that ties in at the top of both stream banks with its apex, or throat, at the approximate stream bed elevation in the stream center, upstream from the stream bank ties. The arms actually slope upstream in a downward direction toward the throat). The project design vertical drop from the throat rock to the water surface below the throat rock was within current regulatory standards. However, natural stream adjustments at four rock vanes resulted in vertical distances that exceeded the preferred threshold for migrating fish. The first solution was to cut notches in the throat rocks of the rock cross-vane structures. During 2005 DCSWCD, NYCDEP, the New York State Department of Environmental Conservation (NYSDEC), the U.S. Army Corps of Engineers (USACOE) and the U.S. Fish and Wildlife Service evaluated the project and decided more was needed. Various methodologies to mitigate the issue were subsequently discussed and evaluated.

This project reach begins at the outlet of a 95" x 67" corrugated metal pipe arch culvert under the Davis Road Town Highway, which is also the property boundary between the two farms owned by the David Post and John Palmatier families, respectively. High flow events in late 2004 and in 2005 created unraveling of the stream upstream of the culvert on the Palmatier property. There was a potential risk that the stream would re-channelize, compromising the town highway, the CREP buffers and pastureland on both

farms. This area was also contributing excessive sediment to the New York City water supply system.

Project Description

The goal of the involved parties is to improve fish passage at four rock cross-vane structures in the upper part of the project reach on the Post farm. It was agreed to retrofit the four cross-vane structures with a cross-bar structure. The cross-bars were placed at approximately one-half the length of the cross-vane and at approximately one-half the elevation between the stream bed at the cross-bar location and the elevation of the throat. This created two smaller pools with a shorter jump height for migrating fish. Rocks on the downstream most rock cross-vane in the original project reach that were dislodged by the June 27, 2006 flood were re-positioned.

To mitigate the upstream situation on the Palmatier farm the goal was to stabilize the stream bed and banks immediately upstream of the culvert. This was accomplished by slight re-alignment of the stream, armoring the stream bed and banks, and installing a rock cross-vane structure to prevent future head-cutting.

The project will be monitored for five years using the existing monitoring protocol developed during the original project implementation of the downstream location. Additional monitoring cross-sections were established to monitor project effectiveness.

Work Performed

Post farm: Site was de-watered by pumping around the work areas. Cross-bar structures were placed at the top three cross-vanes and at the double cross-vane as shown on sheet 2 - 4 of the project drawings entitled “David Post Stream Retrofit” and according to the attached specifications (Attachment D). Gravel backfill was placed behind the cross-bars to seal voids and create the second pool. The left arm downstream most cross-vane was repaired by re-setting the dislodged rocks.

Palmatier farm: Site was de-watered by pumping around the work area. A rock cross-vane structure with cross-bar was constructed on sheets 3 - 5 of the project drawings entitled “John Palmatier Streambank Stabilization” and to the attached specifications. The streambed was re-aligned and re-shaped as shown on sheets 2 and 3 of the project drawings and per the specifications. The streambed and streambanks were reinforced with stone fill and live stake vegetation installed as shown on sheets 3 - 5 of the drawings and according to the specifications (Attachment E).

Project Benefits

- The high quality of New York City's drinking water supplies will be ensured by minimizing sediment and pollutant delivery to the Cannonsville Reservoir by decreasing erosion and deposition.
- The improved and new structures will simultaneously optimize fish passage.
- Establishment of vegetation on streambanks will reinforce the soil with a good root system and provide shade for aquatic fauna.
- An opportunity to further advance the water quality and aquatic habitat benefits of geomorphically designed and constructed stream projects.

Conclusion

Streams are an ever changing part of nature. Erosion, deposition, meandering and flooding are all natural variables in a stream system. These variables rely on and affect each other and are in equilibrium in a stable system. When outside influences such as man's intervention upset one of these variables, one or more of the remaining variables will compensate or may even become exacerbated.

In the case with the lower project location, a project constructed in 2004 to demonstrate a full geomorphic stream restoration has functioned well hydraulically but some fish passage impediments were created. Although the rock cross-vane with cross-bar is currently an accepted practice it is not always necessary to construct the cross-bar component. However, since rock is sized large enough to withstand high flows situations like were created by using large rock in smaller streams can lead to fish passage impediments such as encountered at the David Post project location. As part of the learning experience, this information can be used when preparing future designs and in the education and outreach process.

At times streams adjust beyond some the boundaries we have created for them. In the case with the upper project location, the stream had migrated to a position so that it was no longer in good alignment with a large town highway culvert structure. In such situations it is necessary to assist the stream in order to prevent potential or further private and public property damage.

Geomorphic design and implementation principles and practices take advantage of the natural function of streams. By mitigating an unstable stream situation using these techniques and continuing to monitor there effectiveness, the chances of successful stream mitigation projects can be increased.

Attachment A

Budget

1/10/2011

Bid Tally Sheet - Post Retrofit/Palmatier Stream Stabilization

Post										
Bid Item No.		Units	Estimated Quantities	Estimate	T.C. Briggs					
1	Mobilization & Demobilization	LS		\$5,040.00	\$2,275.00					
2	Pollution Control	LS		\$1,000.00	\$2,500.00					
3	De-watering	LS		\$19,000.00	\$7,500.00					
4	Stream Channel Excavation & Grading	LS		\$0.00						
5	Rock/Cross Vanes (Vane Bars)	LF	47	\$10,200.00	\$6,815.00					
7	Rock/Cross Vanes (Repair Vane @ Sta 11+60)	LS		\$1,200.00	\$2,000.00					
8	Seeding & Mulching	LS		\$2,200.00	\$3,300.00					
Total Bid Price				\$38,640.00	\$24,390.00					\$0.00

Palmatier										
Bid Item No.		Units	Estimated Quantities	Estimate	T.C. Briggs					
1	Mobilization & Demobilization	LS		\$3,600.00	\$3,500.00					
2	Pollution Control	LS		\$2,959.00	\$2,200.00					
3	De-watering	LS		\$6,424.00	\$4,000.00					
4	Geotextile	LS		\$1,171.00	\$800.00					
5	Erosion Control Material	LS		\$1,092.00	\$4,050.00					
6	Stream Channel Excavation & Grading	LS		\$3,864.00	\$9,000.00					
7	Rock/Cross Vanes	LF	50	\$11,100.00	\$7,250.00					
8	Rock Riprap	SF	1,600	\$8,118.00	\$12,800.00					
9	Live Stakes/Posts (Do week of Nov 13)	LS		\$792.00	\$1,500.00					
10	Seeding & Mulching	LS		\$2,700.00	\$3,500.00					
Mod #1	Expand scope of rock cross-vane	LS		\$2,320.00	\$2,320.00					
Total Bid Price				\$44,140.00	\$50,920.00					\$0.00


Totals \$82,780.00 \$75,310.00
Less 10% Palmatier \$5,092.00
Less Incomplete Work \$1,500.00
Invoice 1 Total \$68,718.00

Attachment B



Maps


Delaware County SWCD John Palmatier and Dave Post Projects

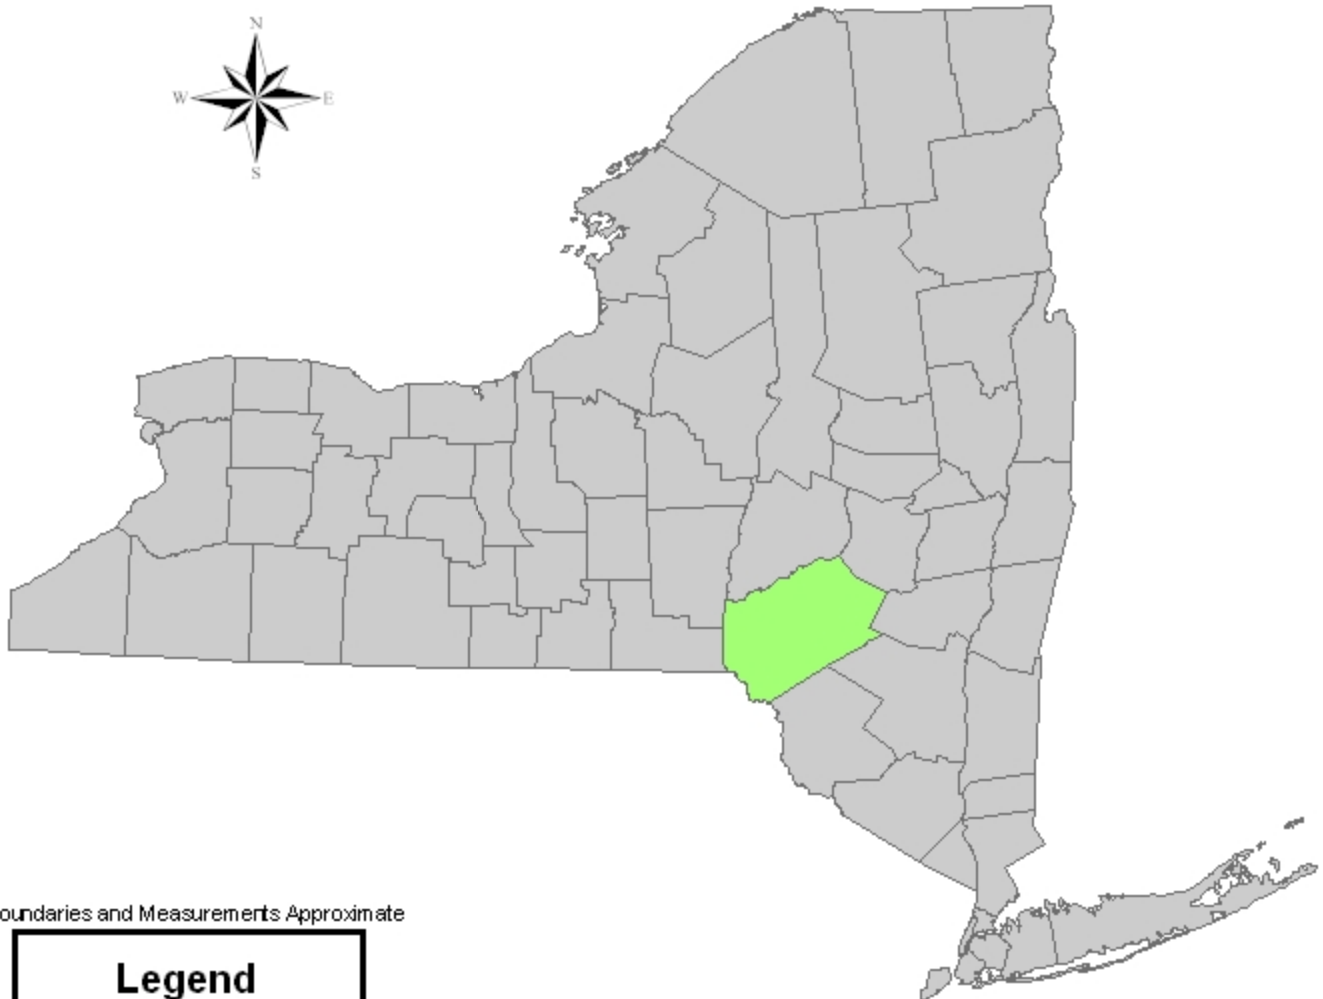Map 1 County Location Map




Boundaries and Measurements Approximate

Legend	
	New York State
	Delaware

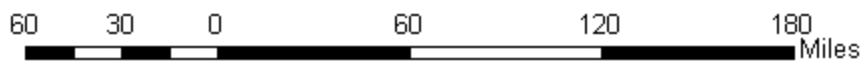


Delaware County SWCD John Palmatier and Dave Post Projects

Map 2 Town Location Map

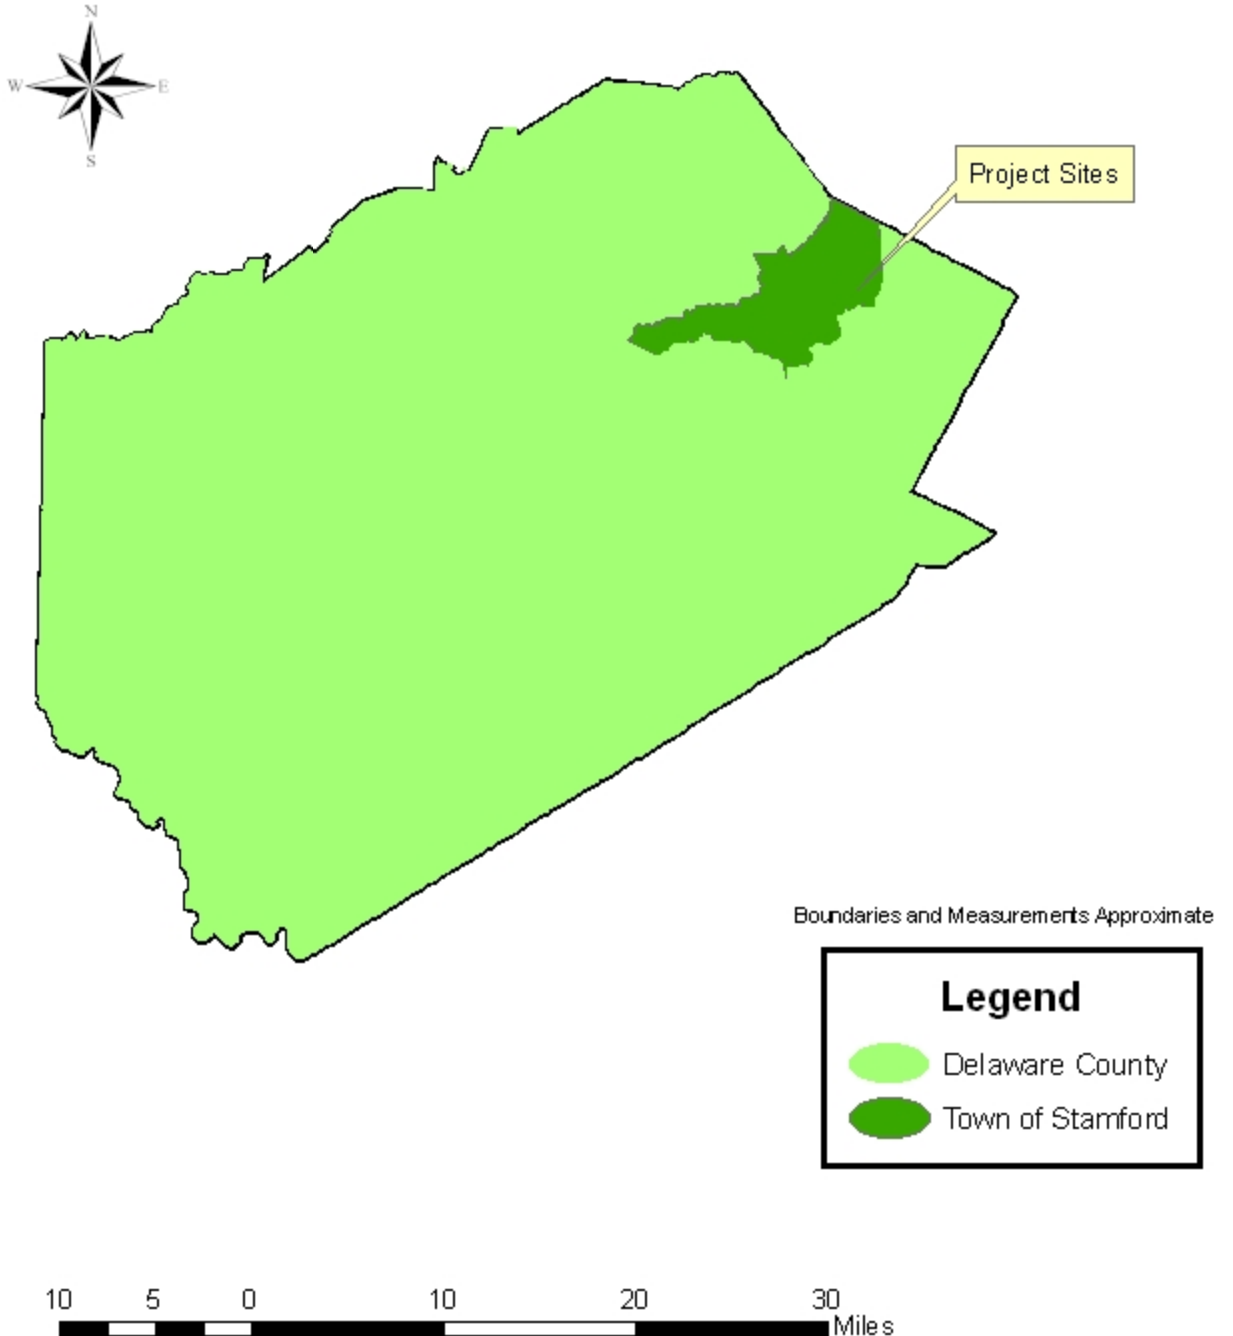

Delaware County SWCD John Palmatier and Dave Post Projects

Map 3 John Palmatier and Dave Post Location Map

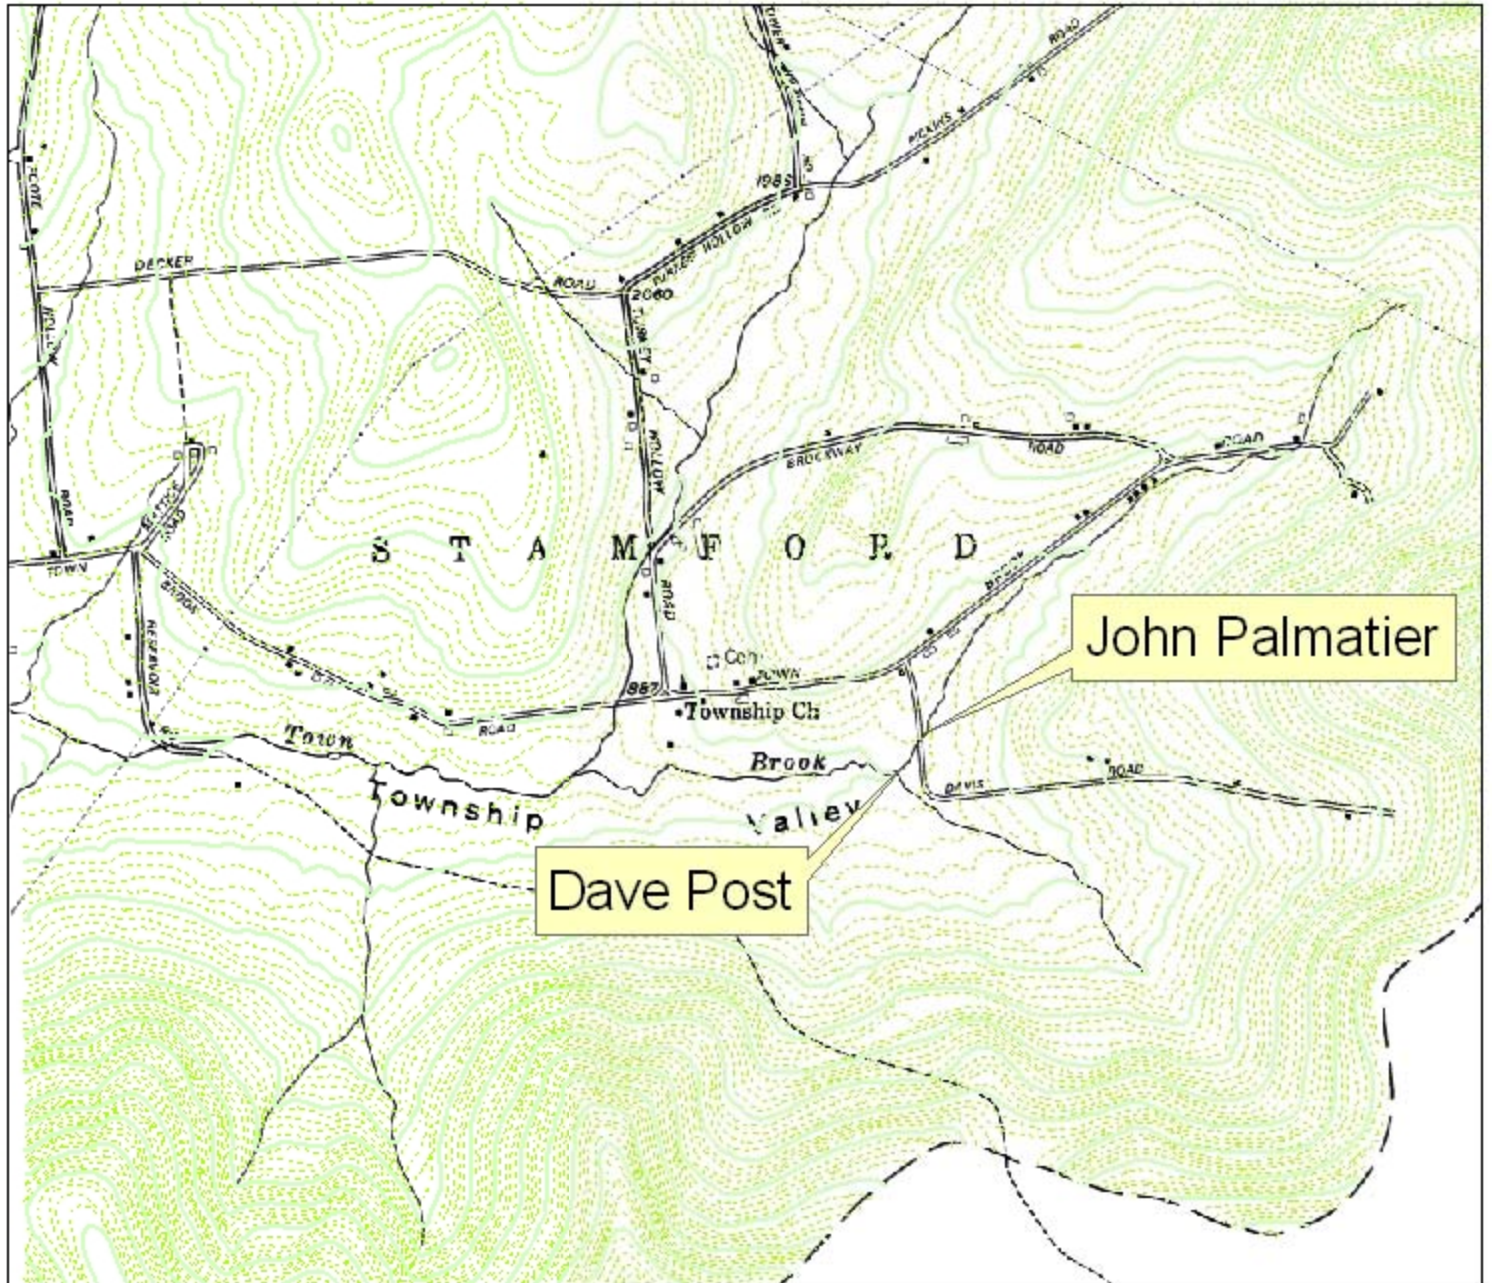

Scale
1:24000
1"=2000'

1,600 800 0 1,600 3,200 4,800
Feet



Attachment C

Photographs

Post Retrofit Project Before and After Photos



Photo 1: Looking upstream at Cross Vane 1 before retrofit.



Photo 2: Looking upstream at Cross Vane 1 after retrofit.

Post Retrofit Project Before and After Photos



Photo 3: Looking upstream at Cross Vane 2 before retrofit.



Photo 4: Looking upstream at Cross Vane 2 after retrofit.

Post Retrofit Project Before and After Photos



Photo 5: Looking upstream at Cross Vane 3 before retrofit.



Photo 6: Looking upstream at Cross Vane 3 after retrofit.

Post Retrofit Project Before and After Photos



Photo 7: Looking upstream at double Cross Vane before retrofit.



Photo 8: Looking upstream at double Cross Vane after retrofit.

Post Retrofit Project Before and After Photos



Photo 9: Looking upstream at the end of project area before construction.



Photo 10: Looking upstream at the end of the project area after construction.

Palmatier Before and After Photos



Photo 1: Looking downstream from upper portion of project site before construction.



Photo 2: Looking downstream from upper portion of project site after construction.

Palmatier Before and After Photos



Photo 3: Looking upstream standing on Davis Road at culvert inlet before construction.



Photo 4: Looking upstream from Davis Road after construction.

Attachment D

**As-built Project Drawings and Project Specifications -
Post Farm**

Dig Safely.
New York
 Underground Facilities Protective Organization
 www.digsafelynewyork.org
800-962-7962

Call Before You Dig
 Wait The Required Time
 Confirm Utility Response
 Respect the Marks
 Dig With Care

CONSTRUCTION NOTES

ALL WORK SHALL BE ACCOMPLISHED ACCORDING TO THE PLANS AND SPECIFICATIONS OF THE PROJECT. ANY CHANGES SHALL BE WITH PRIOR WRITTEN APPROVAL BY THE ENGINEER AND/OR CONTRACTING OFFICER.

AT LEAST TWO FULL WORKING DAYS PRIOR TO EXCAVATION, THE CONTRACTOR SHALL NOTIFY THE UNDERGROUND FACILITIES PROTECTION ORGANIZATION (U.F.P.O.) AT 1-800-962-7962 AND ANY OTHER LOCAL UTILITIES THAT MAY BE IN THE AREA.

THE CONTRACTOR SHALL GIVE THE DCSWCD AND THE LANDOWNER/OPERATOR A MINIMUM OF TWO FULL WORKING DAYS NOTICE PRIOR TO CONSTRUCTION.


ALL CONSTRUCTION PRACTICES SHALL BE IN ACCORDANCE WITH O.S.H.A. STANDARDS AND REGULATIONS PART 1910 AND 1926. ALL TRENCH EXCAVATIONS IN UNSTABLE SOILS OR IN TRENCHES GREATER THAN FIVE FEET DEEP SHALL BE SLOPED, SHORED, OR SHIELDED ACCORDING TO O.S.H.A. PART 1926.

Stream Corridor Management Program
 Delaware Co. SWCD
 David Post Stream Retrofit

CONTENTS

- Sheet 1 : Title Sheet
- Sheet 2 : Plan View
- Sheet 3 : Vane Profile and Plan View
- Sheet 4 : Vane Profile and Plan View
- Sheet 5 : Details

SITE MAP

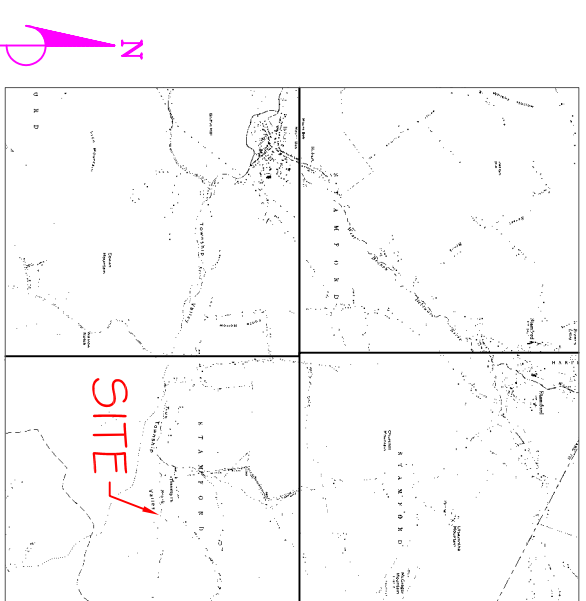

I HAVE REVIEWED THE DRAWINGS AND SPECIFICATIONS FOR THIS PROJECT. THE PROJECT HAS BEEN EXPLAINED TO ME FULLY, AND I AGREE WITH ALL TECHNICAL ASPECTS OF THE PROJECT.

LANDOWNERS
 SIGNATURE: _____ DATE: _____

David Post Stream Retrofit	
Title Sheet	
Delaware Co. Stream Corridor Management Program Delaware Co., NY	
Delaware County Soil & Water Conservation District 44 West Street Walton, NY 13856	
Designed by <u>G. Niese</u>	Date <u>6-02-06</u>
Drawn by <u>G. Niese</u>	Title <u>8-30-06</u>
Traced by <u>S. Glafkos</u>	Sheet No. <u>9-06-06</u>
Checked by <u>S. Glafkos</u>	Drawing No. <u>DE-C-SOIL-001a</u>

Plan View



TBM 1-NAIL/DISK IN CRAB APPLE TREE
ELEV 100.00

Rock Storage Area

Silt Fence

STN 2
ELEV 90.51

Temporary Cattle Fence

STN 5
ELEV 97.31

2 EA - 24" STEEL

24" CMP

STN 3
ELEV 88.02

LEGEND

- Proposed**
- Proposed Vane Bar
 - Temporary Work Limit Fence
 - Coffler Dam/Pump
 - Repair Vane

SEQUENCE OF OPERATIONS

- I. Mobilize
 - A. Construct silt fence around rock storage area.
 - B. Construct temporary cattle fence.
 - C. Construct temporary work limit fence.
- II. Work between 0+00+/- and 4+75+/-
 - A. Construct cofferdam at Davis road culvert inlet and on tributary, install pumps, and pump to pool at 5+50+/-.
 - B. Construct vane bars at cross vane at:
 1. 0+25+/-
 2. 1+30+/-
 3. 2+50+/-
 4. 4+50+/-
- III. Work between 11+50+/- and 12+00+/-
 - A. Construct cofferdam and install pumps at pool at 10+75+/-, Pump to 12+00+/-.
 - B. Repair vane at 11+60+/-.
 - C. Reconstruct riffle to proper grade between 11+00+/- and 11+50+/-.
 - D. Remove cofferdam and dewatering installation. Repair any damage to pool at 10+75+/- caused by dewatering, if necessary.
 - E. Regrade floodplain damaged during construction and seed and mulch.
- IV. Demobilize
 - A. Remove all pollution control devices.

LEGEND

Existing

- Edge Stream
- 2005 Existing Trailweg
- Existing Fence
- Farm Road
- Ditch
- Traverse Point
- TBM
- Cattle Crossing
- Dumped Rock
- Cattle Water Tank
- Vane Structure(2005)
- Existing Live Stake Planting

Not To Scale


David Post Stream Retrofit

Plan View
Delaware Co. Stream Corridor Management Program
Delaware Co., NY
Delaware County Soil & Water Conservation District
44 West Street
Walton, NY 13856

Designed	G. Neale	Date	6-12-06	Approved by	
Drawn	G. Neale	Date	8-30-06		
Traced		Date			
Checked	S. Gadsdome	Date	9-06-06	Drawing No.	DEC-SCMP-001a


NOTE: Location of temporary cattle fence and temporary work limit fence will be established in the field by DCSWCD staff. Relocation of either or both fences may be required during construction.

Vane @ 0+30

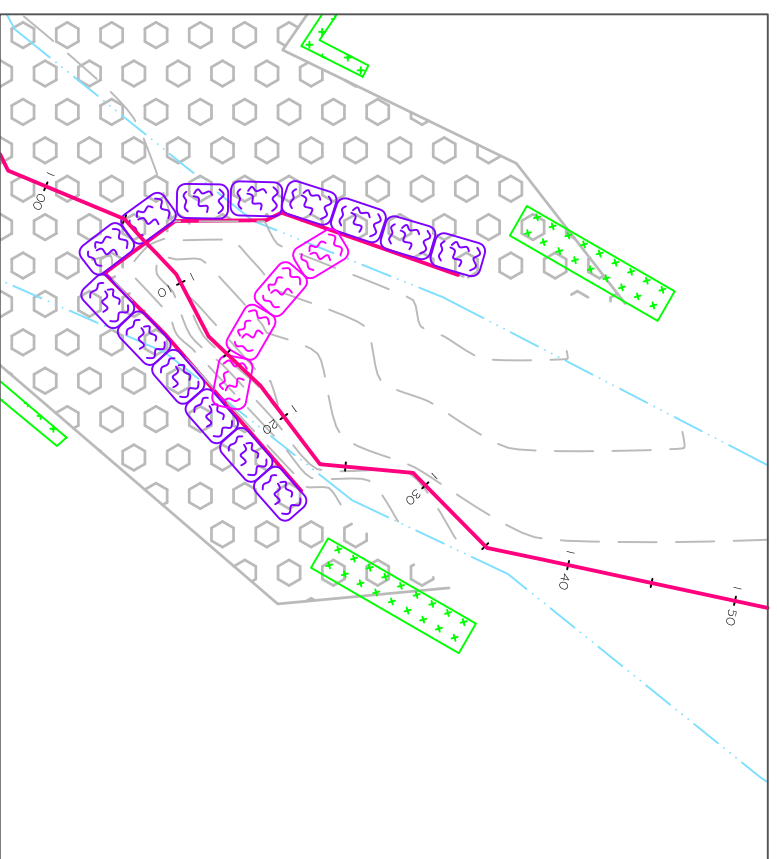





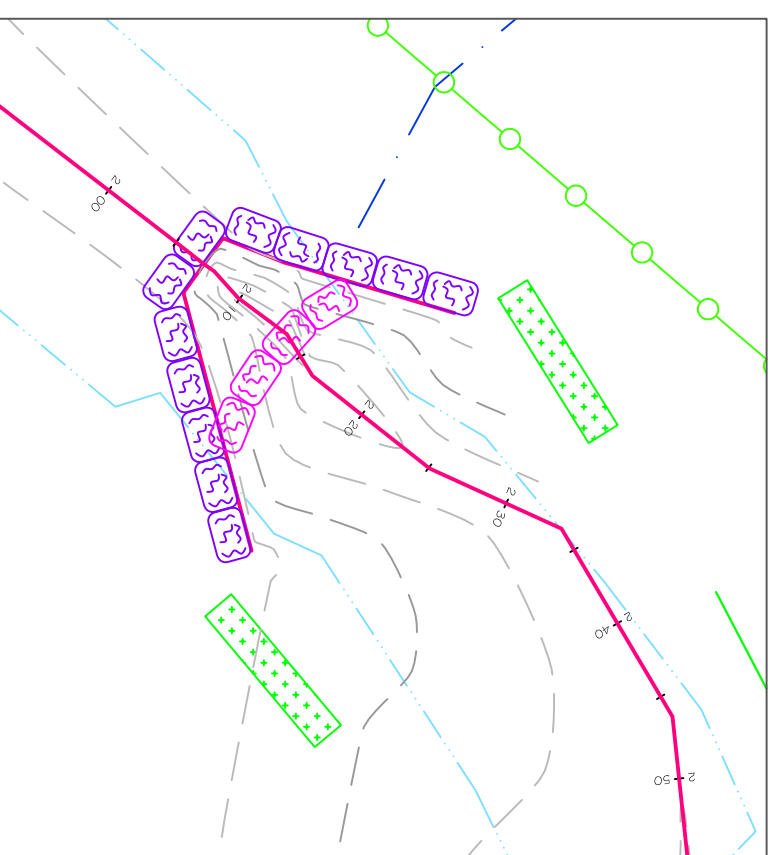





Proposed
Plan View

Vane @ 1+35





LEGEND

-  Edge Stream
-  2005 Existing Trailway
-  Existing Major Contour
-  Existing Minor Contour
-  Ditch
-  Proposed Vane Structure
-  Existing Vane Structure (2005)
-  Existing Dumped Rock
-  Existing Live Stake Planting
-  Existing Willow Fascine

Not To Scale




Proposed
Profile

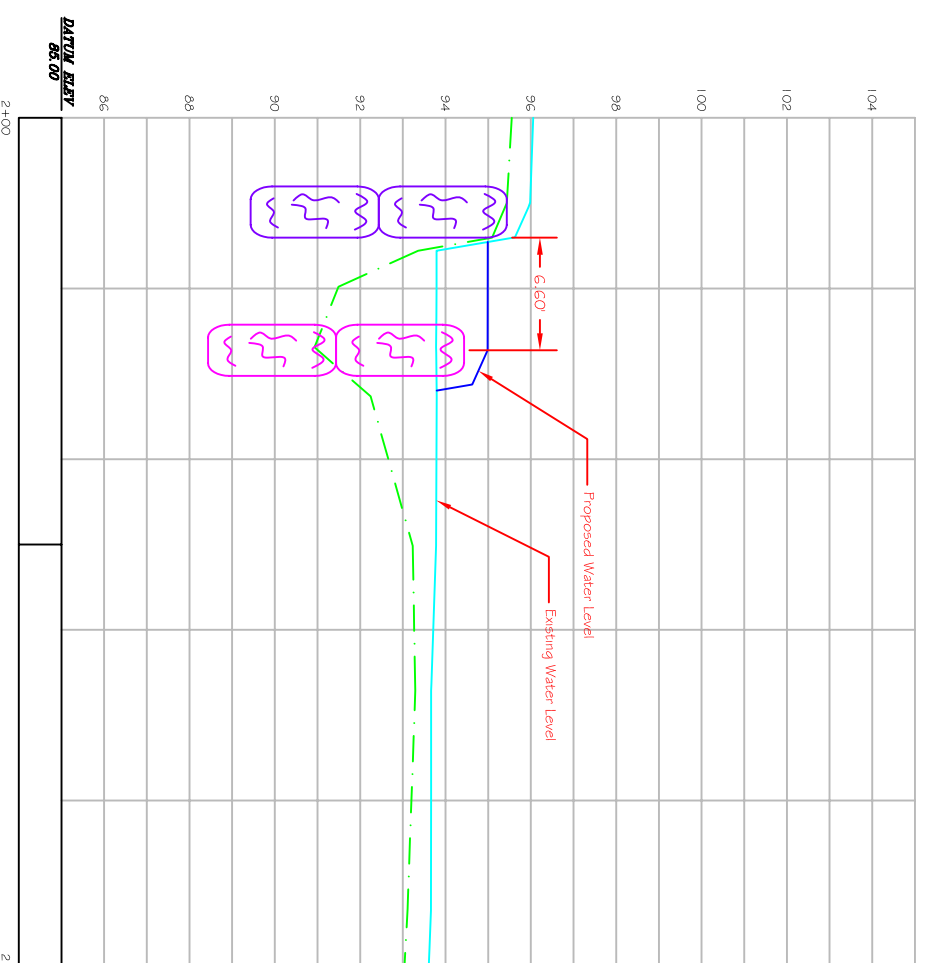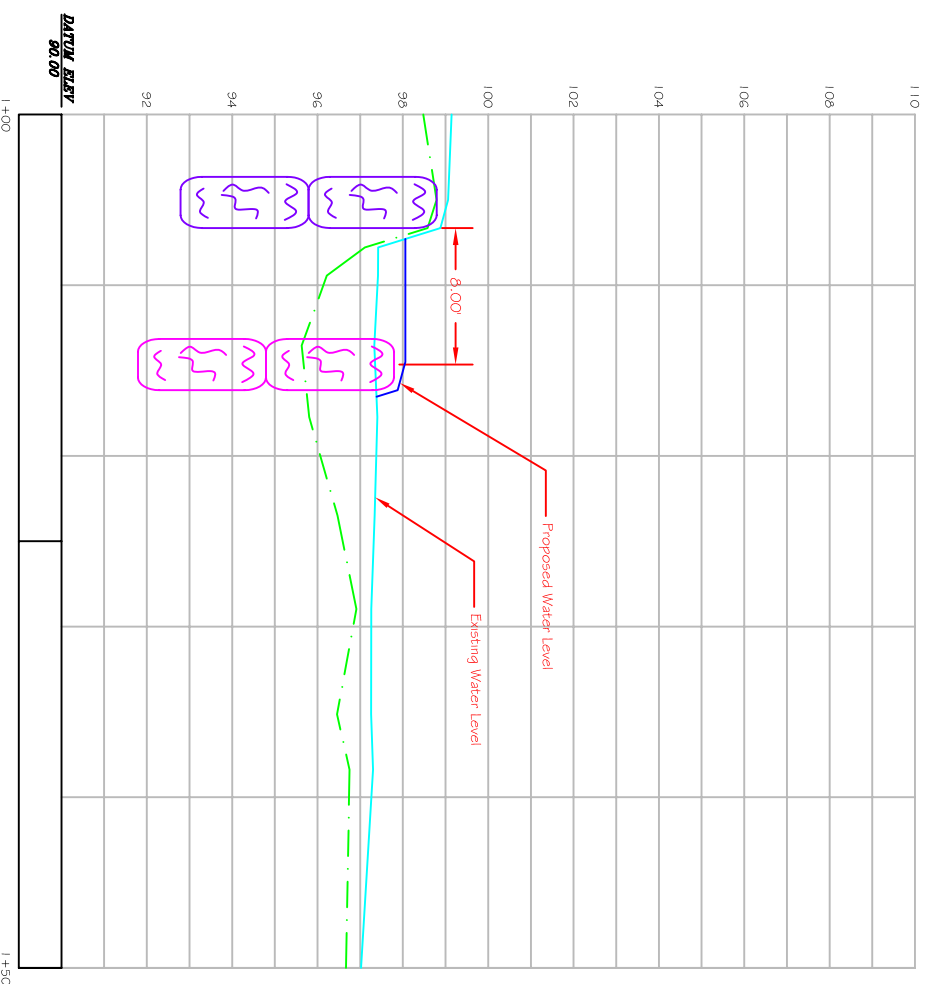


David Post Stream Retrofit	
Vane Profile and Plan View	
Delaware Co. Stream Corridor Management Program	
Delaware County Soil & Water Conservation District	
44 West Street	
Walton, NY 13856	
Designed by	G. Nedic
Drawn by	G. Nedic
Checked by	S. Gadsdome
Date	6-12-06
Scale	AS-SC
Project No.	DEC-SCMP-001a

Vane @ 2+40

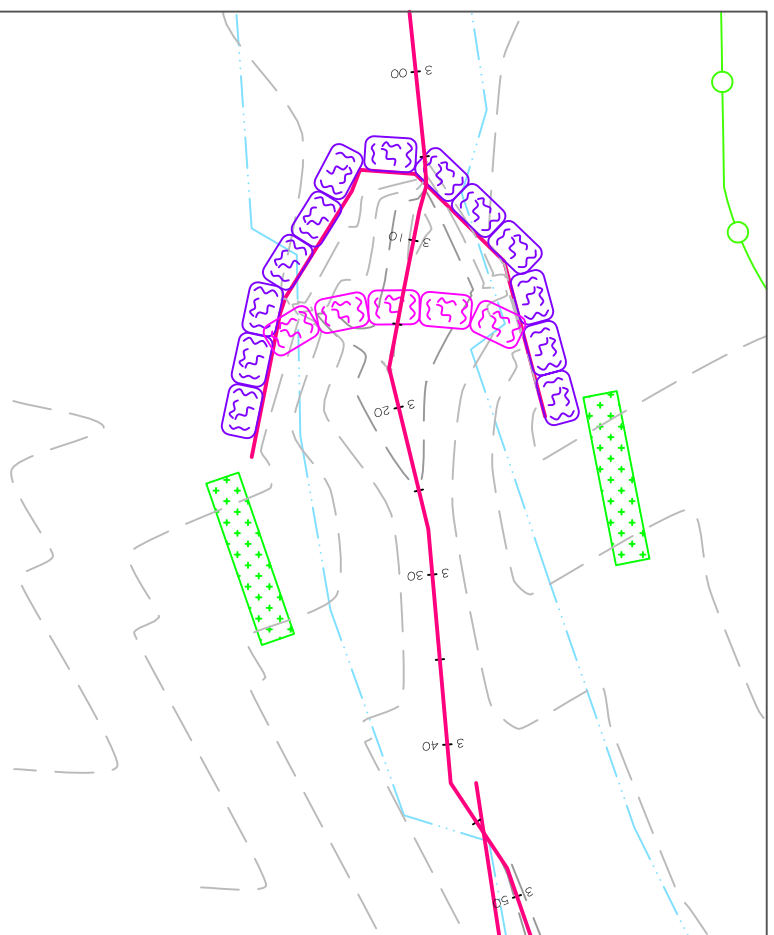





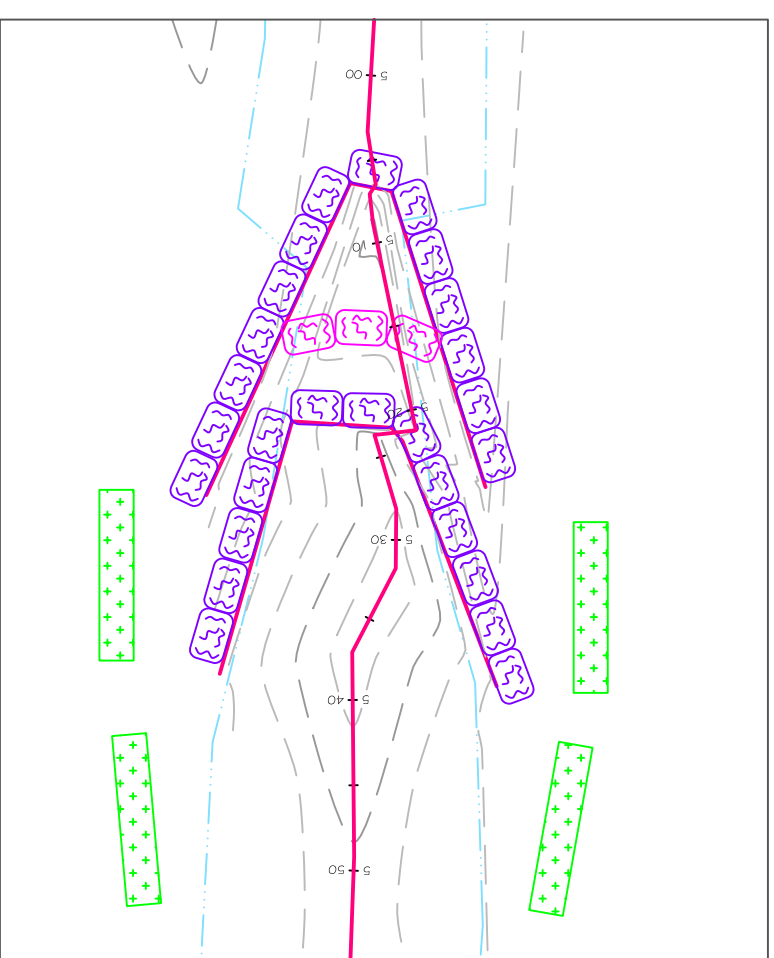

Proposed Plan View

Vanes @ 4+35 and 4+50





LEGEND

-  Edge Stream
-  2005 Existing Thalweg
-  Existing Major Contour
-  Existing Minor Contour
-  Proposed Vane Structure
-  Existing Vane Structure (2005)

 Existing Live Stake Planting

Proposed Profile

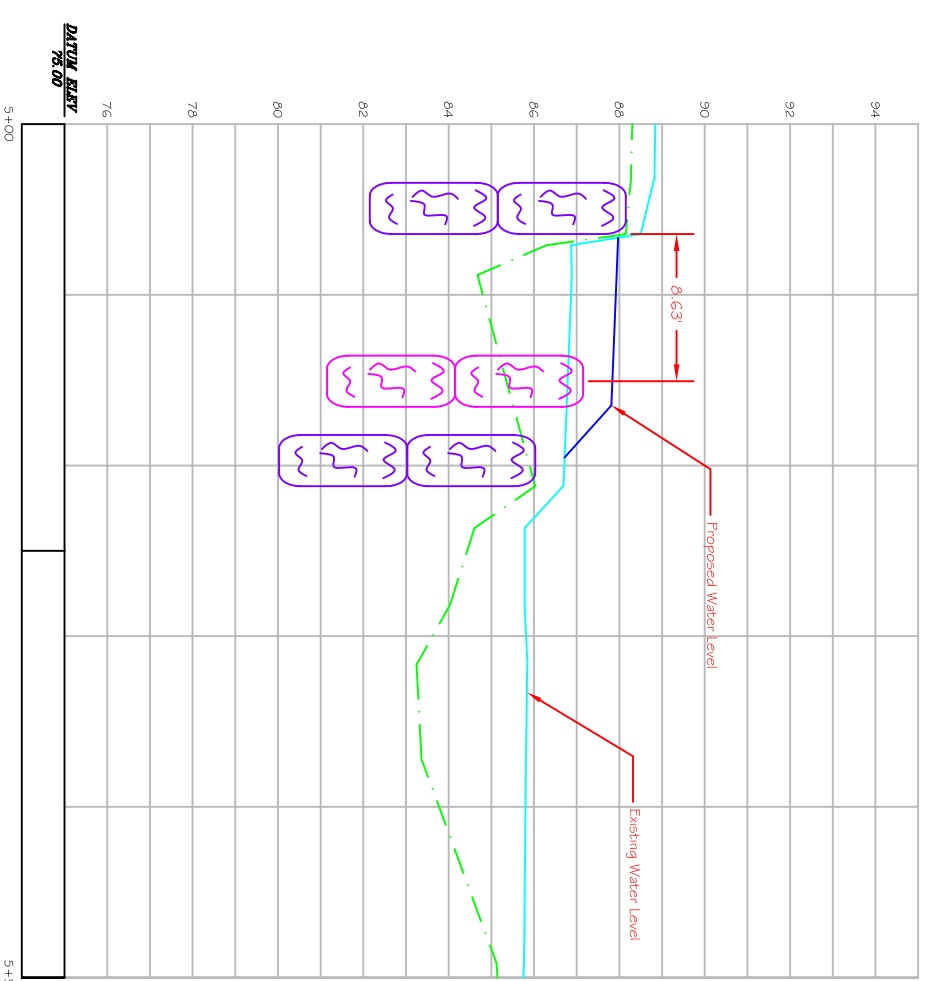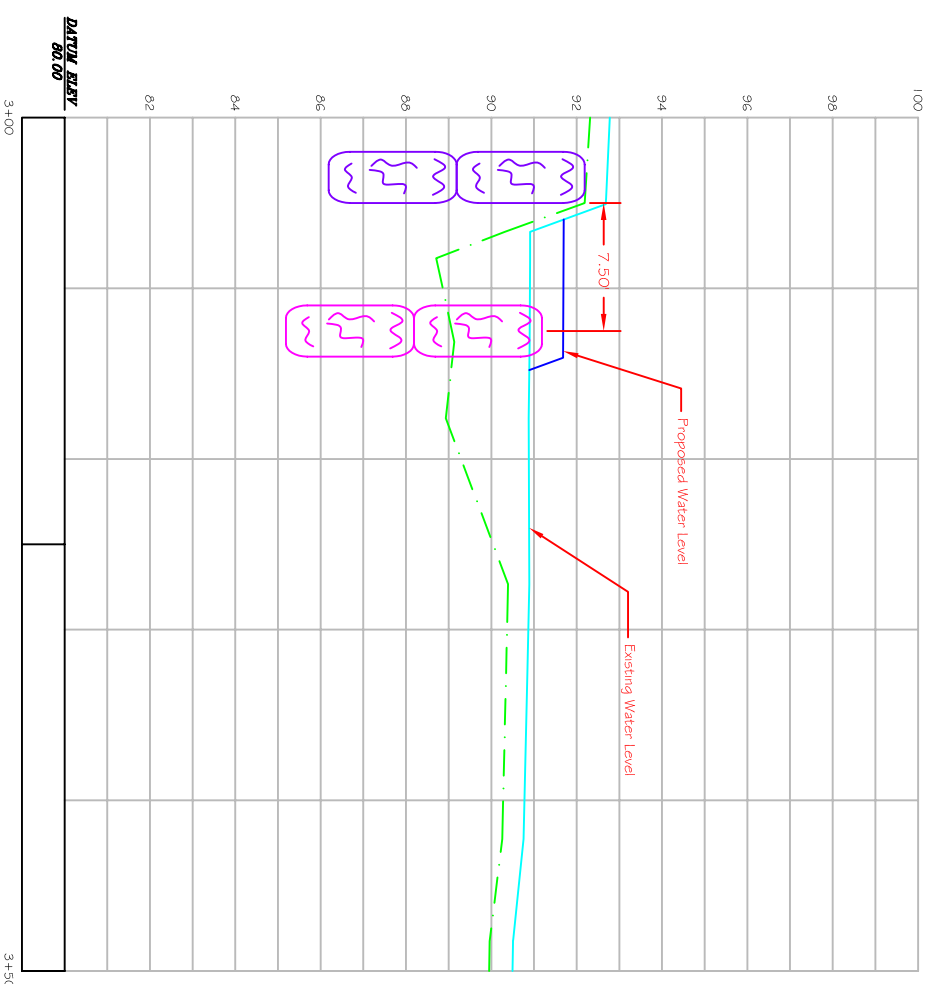








Not To Scale



David Post Stream Retrofit	
Vane Profile and Plan View	
Delaware Co. Stream Corridor Management Program	
Delaware Co., NY	
Delaware County/ Soil & Water Conservation District	
44 West Street	
Walton, NY 13856	
Designed by	G. Neale
Drawn by	G. Neale
Checked by	S. Gadsdome
Traced by	S. Gadsdome
Design No.	DEC-SCMP-001a
Scale	As Shown
Date	9-06-06
Approved by	
Date	


Vane Details

Use Schematically for Vane Bar Construction

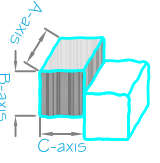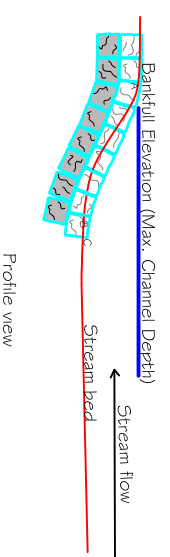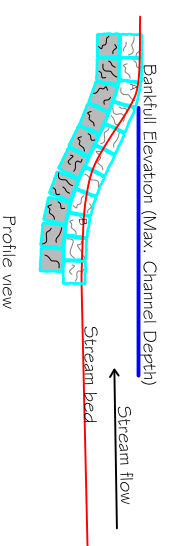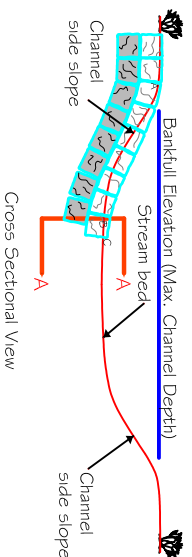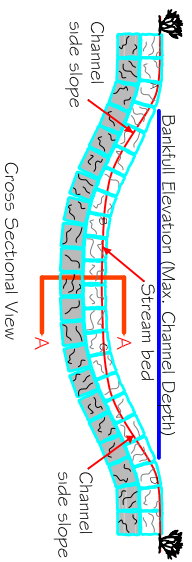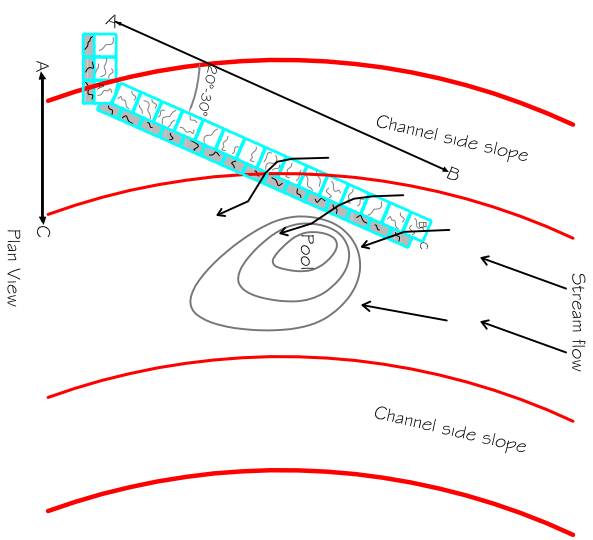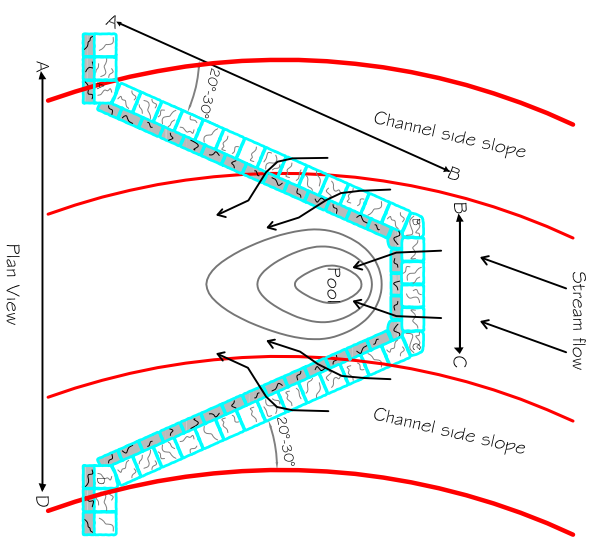

Coffer Dam Detail



(Not to Scale)

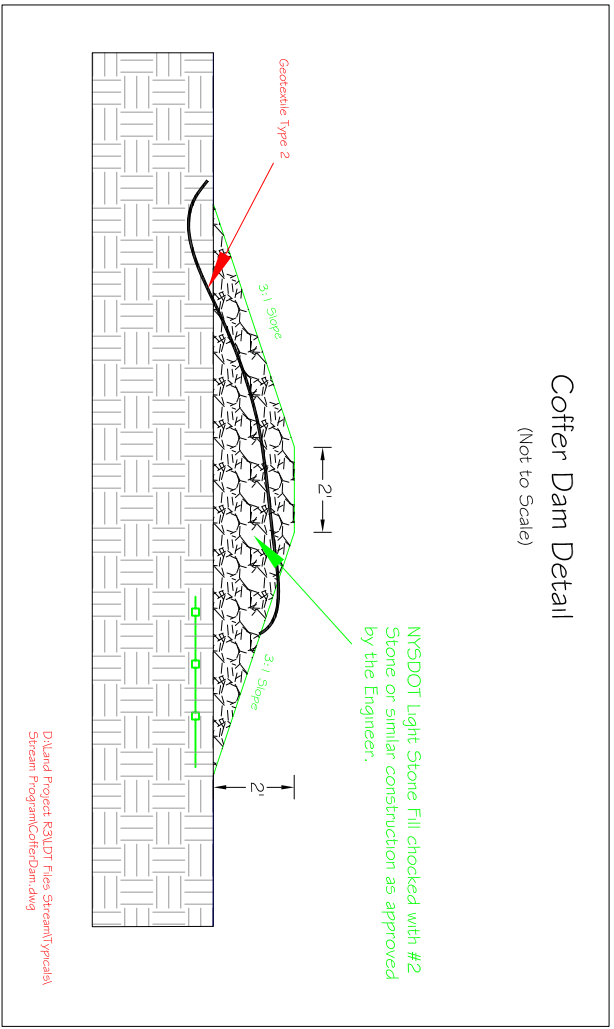

MUSDOT Light Stone Fill checked with #2 Stone or similar construction as approved by the Engineer.

Silt Fence Details

(Not to scale)

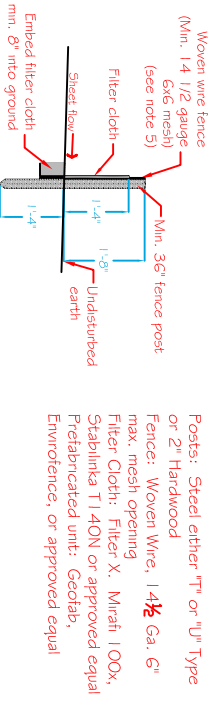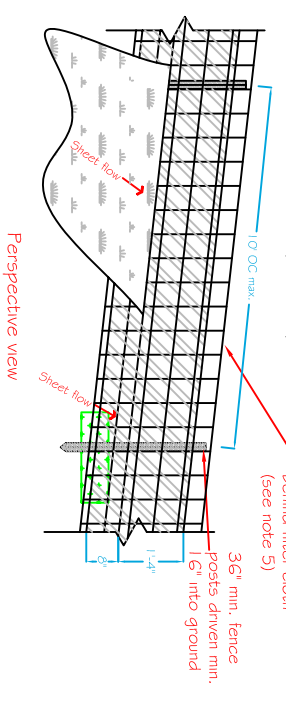


1. Woven wire fence to be fastened securely to fence posts with wire ties or staples.
2. Filter cloth to be fastened securely to woven wire fence with ties spaced every 24" at top and mid section.
3. When two sections of filter cloth adjoin each other they shall be overlapped by six inches and folded.
4. Maintenance shall be performed as needed and material removed when "bulges" develop in the silt fence.
5. Pre-fabricated units do not require the use of woven wire fence.

Rock Top/Footer Detail

Section A-A

Not to scale

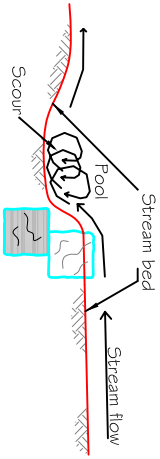

Construction Notes

1. The construction of all structures will be done in the presence of the engineer or his designee.
2. The size and placement of scour holes will be determined by the engineer. See construction specifications.
3. The bank key for all rock structures will be a minimum of seven feet (7') in length, unless otherwise determined by the engineer.

David Post-Stream Retrofit

Details

Delaware Co. Stream Corridor Management Program

Delaware Co., NY

Delaware County Soil & Water Conservation District

44 West Street

Walton, NY 13856

Designed	G. Neale	Date	6-03-06	Approved by	
Drawn	G. Neale	Date	8-30-06	Checked	
Traced		Date		Checked	5. Gadsstone 9-06-06
Scale		Date		Checked	5. Gadsstone 9-06-06
Sheet No.		Date		Checked	5. Gadsstone 9-06-06
Project No.		Date		Checked	5. Gadsstone 9-06-06
Project Title		Date		Checked	5. Gadsstone 9-06-06
Project Location		Date		Checked	5. Gadsstone 9-06-06
Project Description		Date		Checked	5. Gadsstone 9-06-06
Project Status		Date		Checked	5. Gadsstone 9-06-06
Project Contact		Date		Checked	5. Gadsstone 9-06-06
Project Manager		Date		Checked	5. Gadsstone 9-06-06
Project Engineer		Date		Checked	5. Gadsstone 9-06-06
Project Designer		Date		Checked	5. Gadsstone 9-06-06
Project Drafter		Date		Checked	5. Gadsstone 9-06-06
Project Checker		Date		Checked	5. Gadsstone 9-06-06
Project Approver		Date		Checked	5. Gadsstone 9-06-06
Project Title		Date		Checked	5. Gadsstone 9-06-06
Project Location		Date		Checked	5. Gadsstone 9-06-06
Project Description		Date		Checked	5. Gadsstone 9-06-06
Project Status		Date		Checked	5. Gadsstone 9-06-06
Project Contact		Date		Checked	5. Gadsstone 9-06-06
Project Manager		Date		Checked	5. Gadsstone 9-06-06
Project Engineer		Date		Checked	5. Gadsstone 9-06-06
Project Designer		Date		Checked	5. Gadsstone 9-06-06
Project Drafter		Date		Checked	5. Gadsstone 9-06-06
Project Checker		Date		Checked	5. Gadsstone 9-06-06
Project Approver		Date		Checked	5. Gadsstone 9-06-06

Attachment E

**As-built Project Drawings and Project Specifications -
Palmatier Farm**



 Underground Facilities Protective Organization

800-962-7962

 www.digsafelynewyork.org

 Call Before You Dig

 Wait The Required Time

 Confirm Utility Response

 Respect the Marks

 Dig With Care

CONSTRUCTION NOTES

ALL WORK SHALL BE ACCOMPLISHED ACCORDING TO THE PLANS AND SPECIFICATIONS OF THE PROJECT. ANY CHANGES SHALL BE WITH PRIOR WRITTEN APPROVAL BY THE ENGINEER AND/OR CONTRACTING OFFICER.

AT LEAST TWO FULL WORKING DAYS PRIOR TO EXCAVATION, THE CONTRACTOR SHALL NOTIFY THE UNDERGROUND FACILITIES PROTECTION ORGANIZATION (U.F.P.O.) AT 1-800-962-7962 AND ANY OTHER LOCAL UTILITIES THAT MAY BE IN THE AREA.

THE CONTRACTOR SHALL GIVE THE DCSWCD AND THE LANDOWNER/OPERATOR A MINIMUM OF TWO FULL WORKING DAYS NOTICE PRIOR TO CONSTRUCTION.

ALL CONSTRUCTION PRACTICES SHALL BE IN ACCORDANCE WITH O.S.H.A. STANDARDS AND REGULATIONS PART 1910 AND 1926. ALL TRENCH EXCAVATIONS IN UNSTABLE SOILS OR IN TRENCHES GREATER THAN FIVE FEET DEEP SHALL BE SLOPED, SHORED, OR SHIELDED ACCORDING TO O.S.H.A. PART 1926.


I HAVE REVIEWED THE DRAWINGS AND SPECIFICATIONS FOR THIS PROJECT. THE PROJECT HAS BEEN EXPLAINED TO ME FULLY, AND I AGREE WITH ALL TECHNICAL ASPECTS OF THE PROJECT.

LANDOWNERS
SIGNATURE: _____ DATE: _____

Stream Corridor Management Program
Delaware Co. SWCD
John Palmatier
Streambank Stabilization

CONTENTS


- Sheet 1 : Title Sheet
- Sheet 2 : Existing Plan View
- Sheet 3 : Proposed Plan View and Profile
- Sheet 4 : Cross Sections
- Sheet 5 : Details

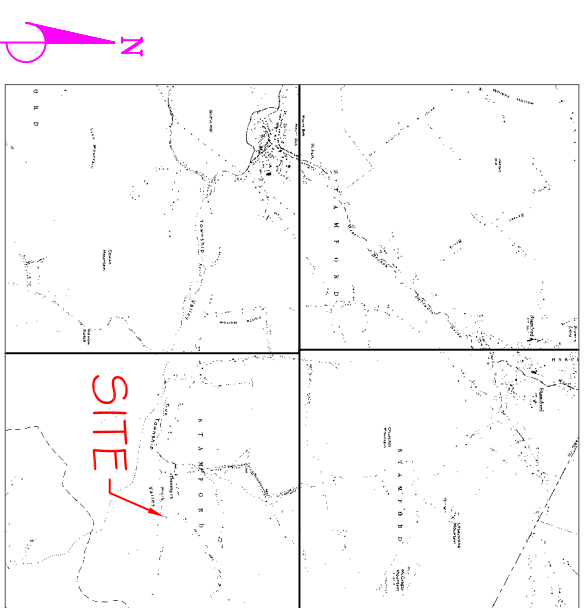

SITE MAP

John Palmatier Streambank Stabilization Title Sheet	
Delaware Co. Stream Corridor Management Program Delaware Co., NY	
Delaware County Soil & Water Conservation District 44 West Street Walton, NY 13856	
Designed: G. Niese Drawn: G. Niese Traced: _____ Checked: S. Gludtsoe	Date: 5-31-06 Title: _____ Approved by: _____ Title: _____ Drawing No: 9-06-06 Drawing Title: _____ Drawing No: 9-07-06 Drawing Title: DE-C-SOIL-009

Existing Plan View

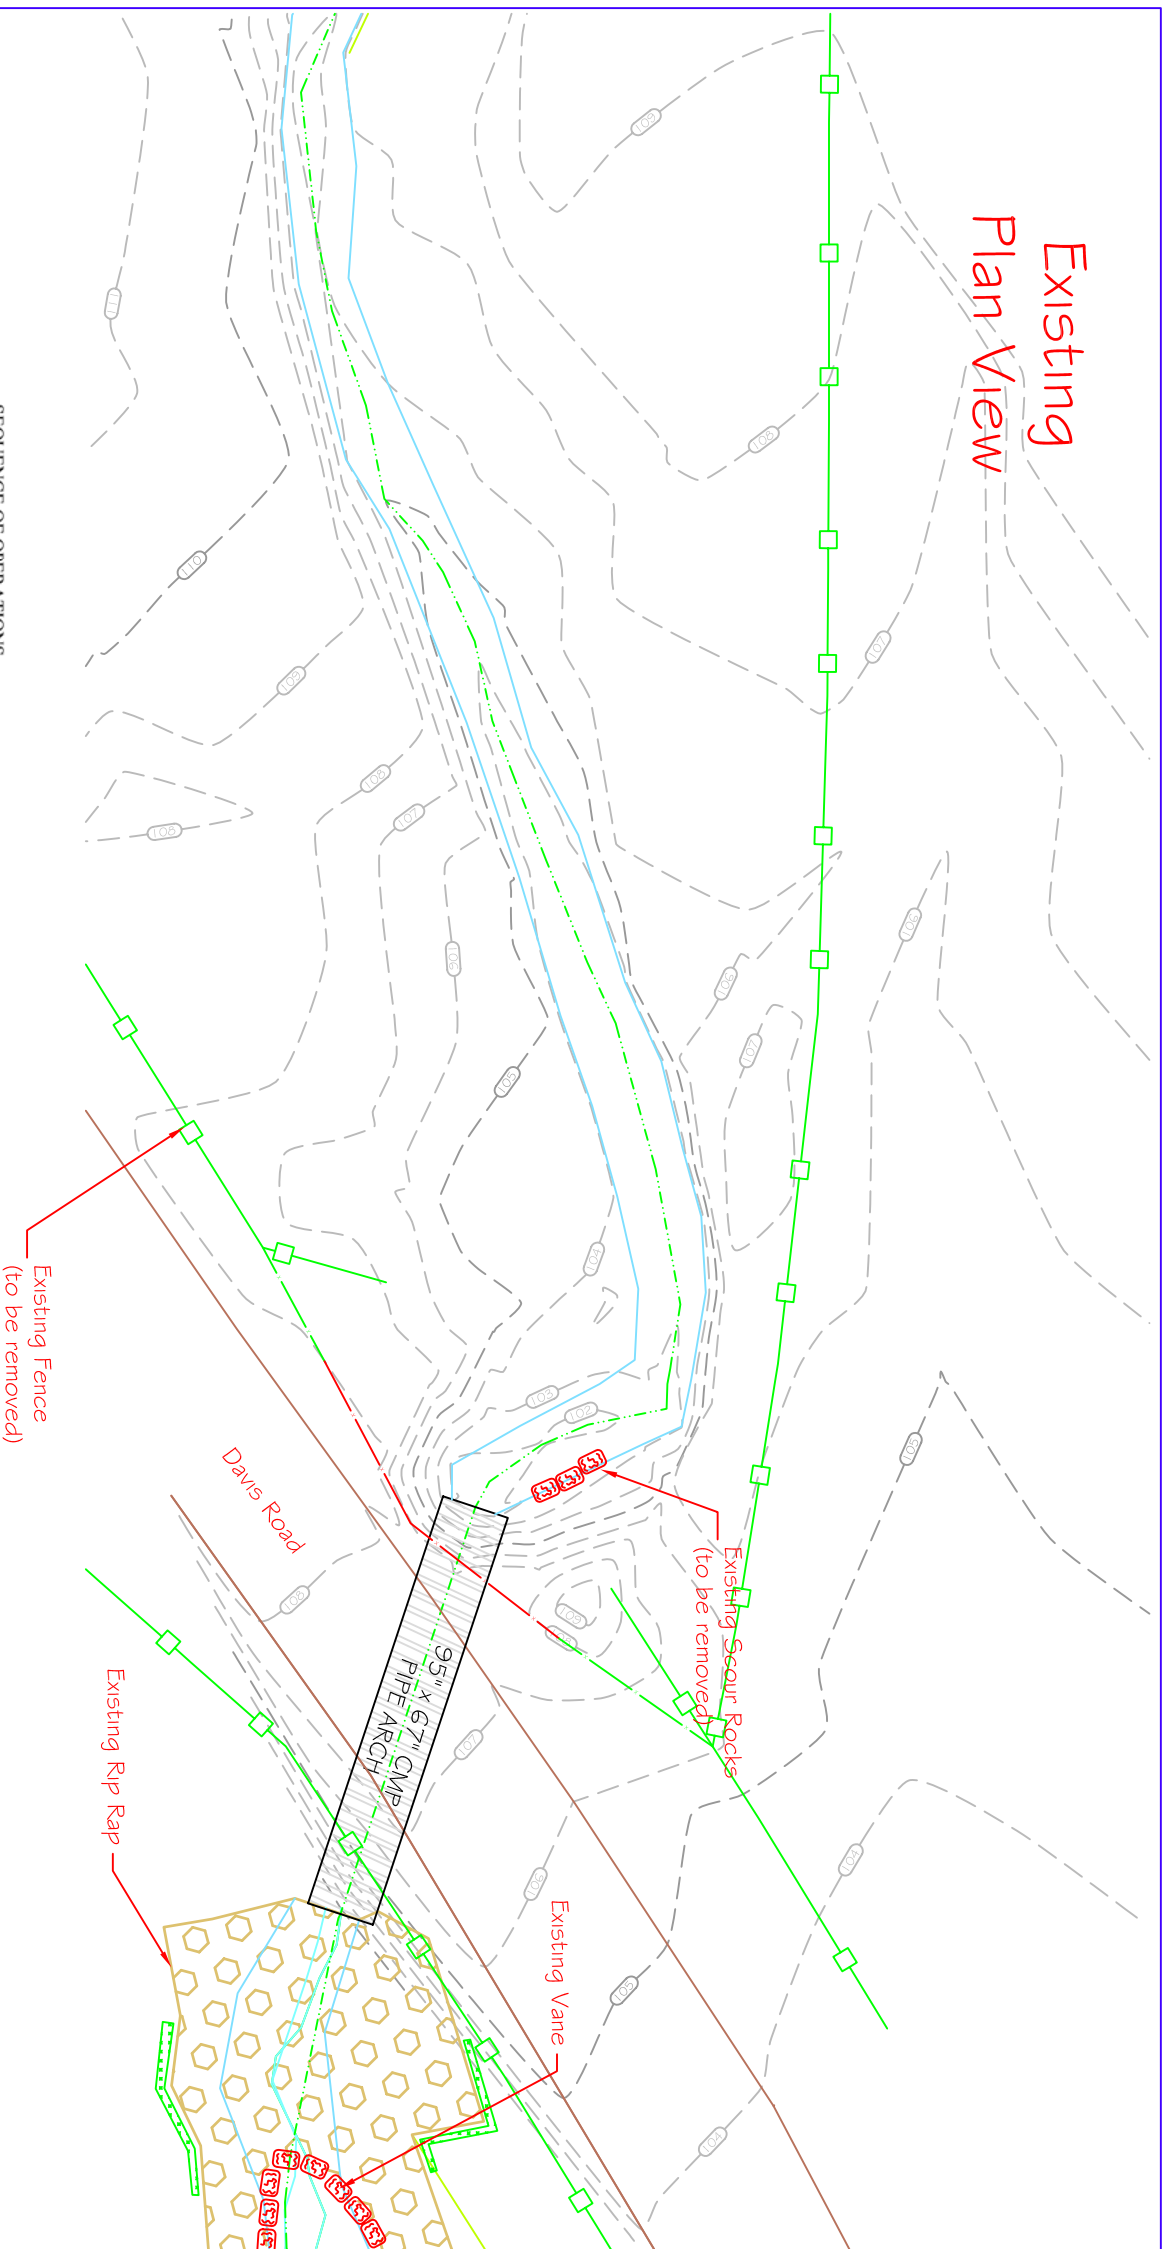


SEQUENCE OF OPERATIONS

- I. Mobilization & Preliminary Operations
 - A. Install temporary fence.
 - B. Construct Rock Storage Area and Temporary Storage Area.
 - C. Construct filter fence at both storage areas.
 - D. Place any stripped topsoil in the Temporary Storage Area.
 - E. Place any other earthwork material in the Temporary Storage Area; keep it separate from the topsoil.
 - F. Cover topsoil with mulch or plastic.
- II. Work at 0+50 +/- to 1+50 +/-
 - A. Construct coffer dam and install pumps at 0+50 +/-.
 - B. Install hose(s) and pump water to 2+00 +/-.
 - C. Grade channel and banks to the elevations as shown on the plans and cross-sections. Store any excess material in the Temporary Storage Area.
 - D. Install Cross Vane at 0+60.
 - E. Construct rip-rap at the locations and elevations as shown on the plans and cross-sections.
 - F. Remove coffer dam, hoses and pumps.
- III. Seeding & Planting
 - A. Seed and mulch all disturbed areas in accordance with the plans and specifications.
 - B. Install Erosion Control Mat as shown on the plans and cross-sections.
 - C. Install Live Stakes in accordance with the plans and specifications.
- IV. Cleanup and Demobilization
 - A. Remove filter fence, clean up storage areas, including seeding, mulching and regrading.
 - B. Remove all equipment, tools, and unused materials from site.

LEGEND


- Existing Edge Stream
- Existing Thalweg
- Existing Fence
- Road Edge
- Existing Major Contour
- Existing Minor Contour
- Existing Culvert Pipe
- Existing Rip Rap

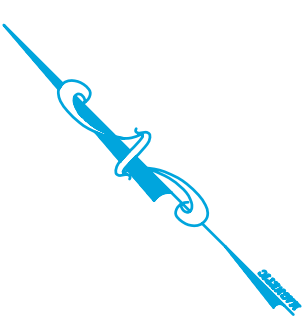

Not To Scale

John Palmater Streambank Stabilization Existing Plan View Delaware Co. Stream Corridor Management Program Delaware Co., NY		Designed by G. Niese 5-5-06		Approved by _____ Title _____	
Delaware County Soil & Water Conservation District 44 West Street Walton, NY 13656		Drawn by G. Niese 9-06-06		Date _____ Title _____	
Project 5. Gladesville		Date 9-07-06		Sheet No. 1 of 3	
Drawing No. DE-C-SQMF-009					


Proposed Plan View

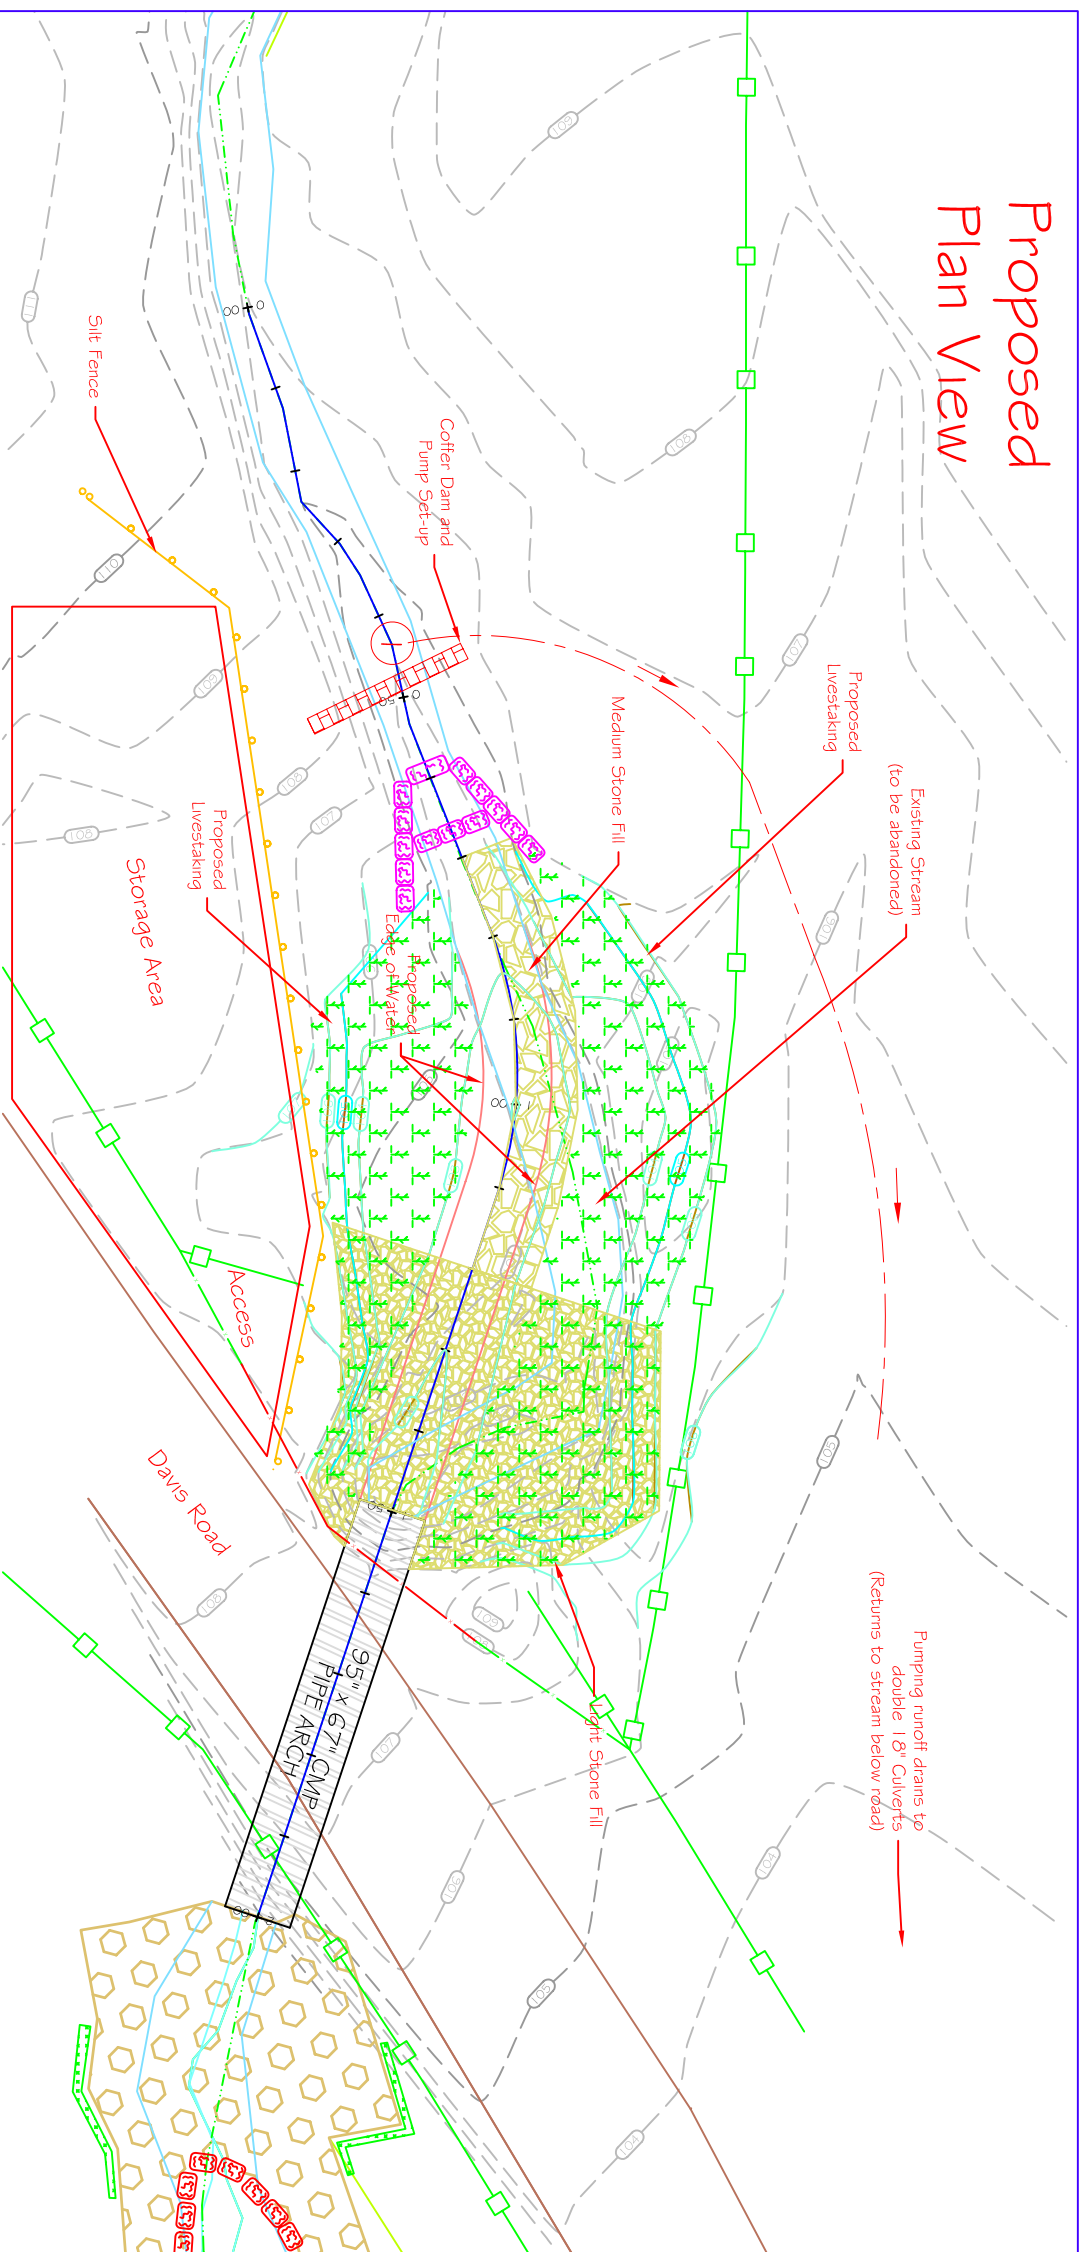

LEGEND




- Existing Edge Stream
- Existing Thalweg
- Existing Fence
- Road Edge
- Existing Contour
- Proposed Contour
- Proposed Centreline
- Proposed Edge Stream
- Proposed Light Stone Fill
- Proposed Medium Stone Fill
- Proposed Livestaking
- Bypass Pump setup
- Coffler Dam
- Existing Culvert Pipe
- Existing Rip Rap

Proposed Profile

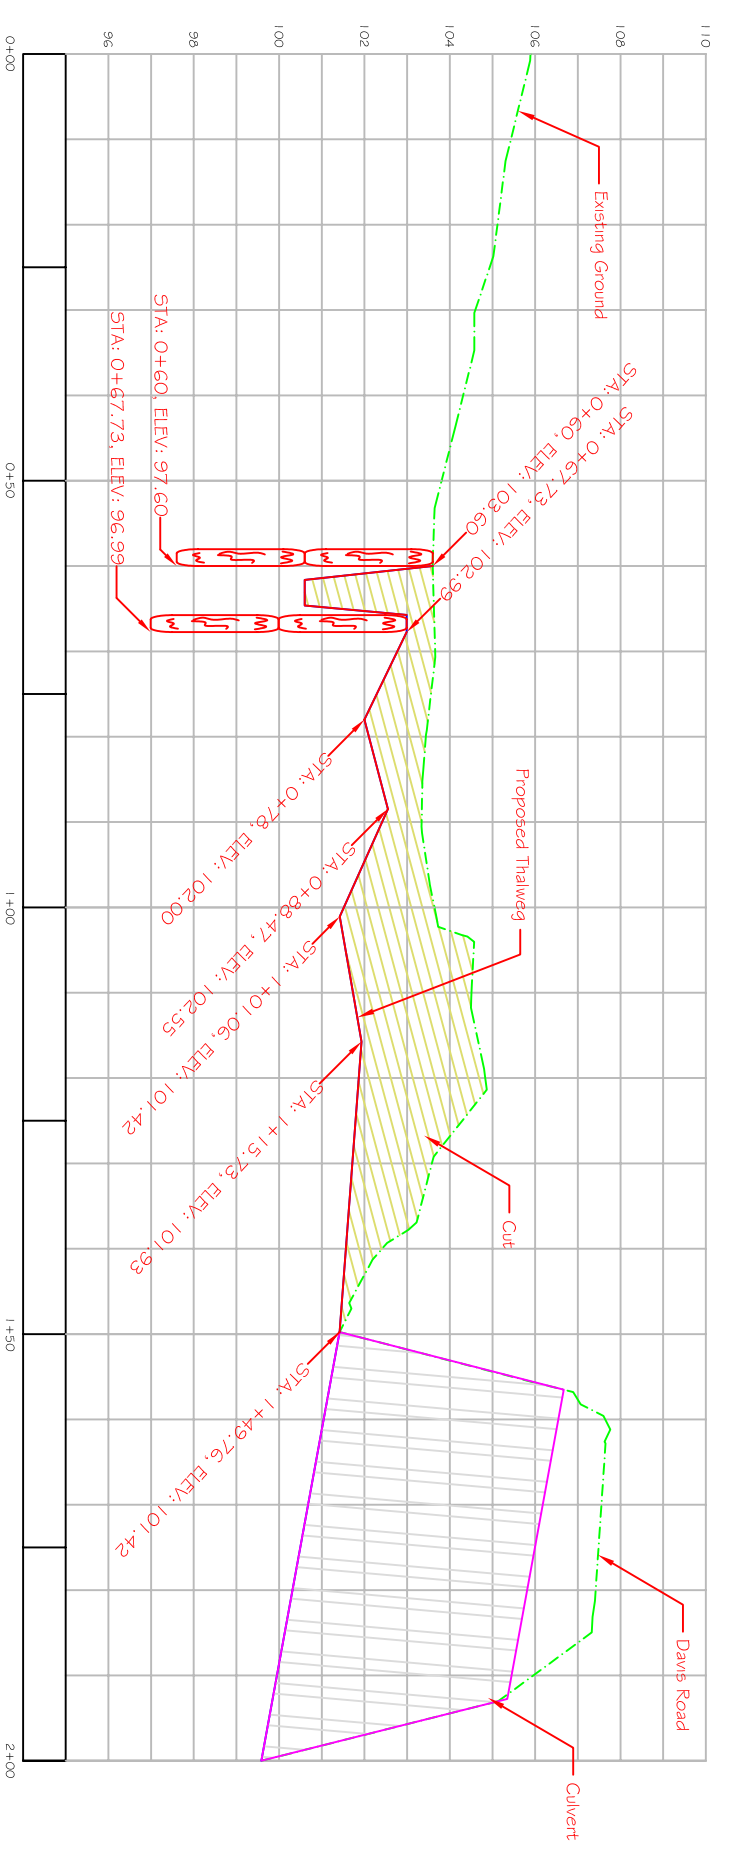










Not To Scale

John Palmater Streambank Stabilization Proposed Plan View & Profile Delaware Co. Stream Corridor Management Program Delaware Co., NY	
Delaware County Soil & Water Conservation District 44 West Street Walton, NY 13656	
Designed: G. Niese Date: 5-5-06	Approved by: _____ Title: _____
Drawn: G. Niese Date: 9-06-06	Title: _____ Date: _____
Project: _____ Sheet No.: _____ of _____	Drawing No.: DE-C-SQMP-009

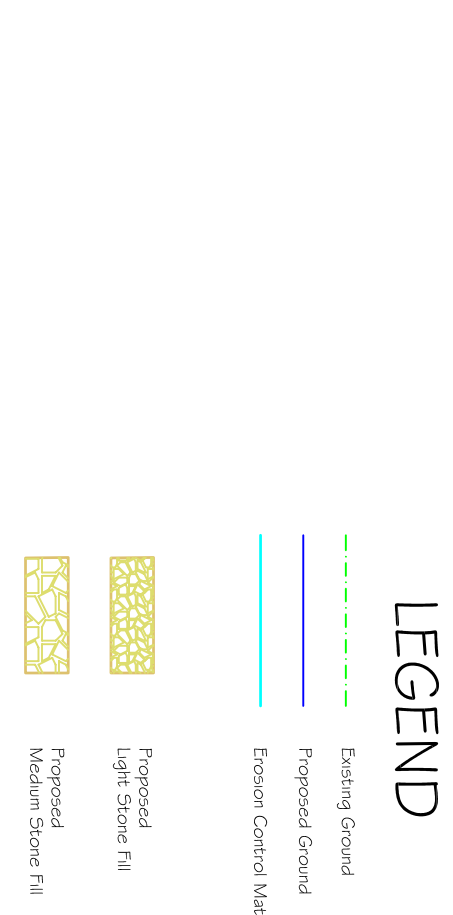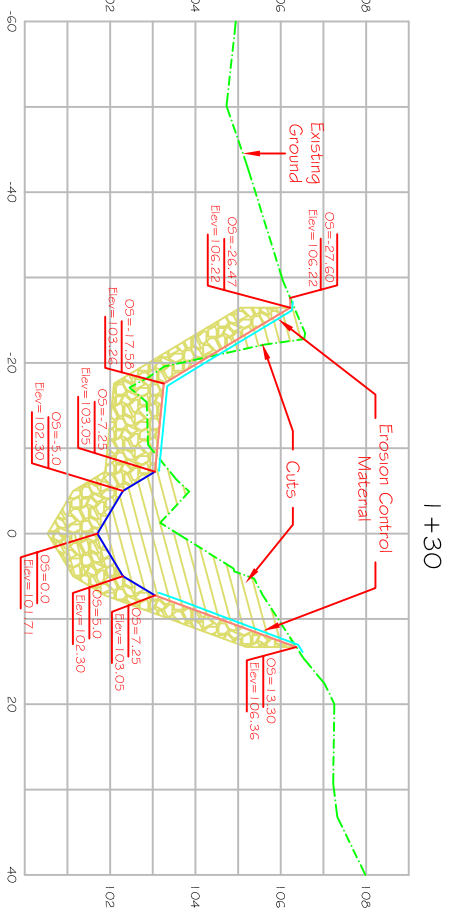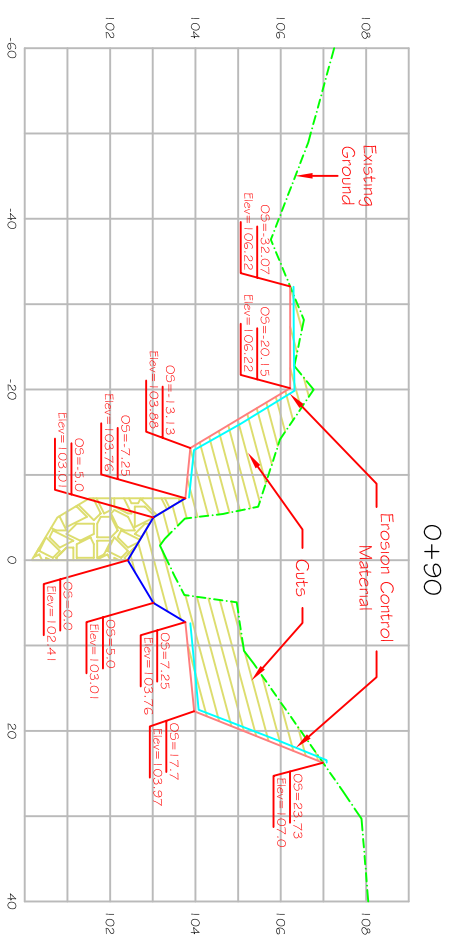

LEGEND

- Existing Ground
- Proposed Ground
- Erosion Control Mat
- Proposed Light Stone Fill
- Proposed Medium Stone Fill

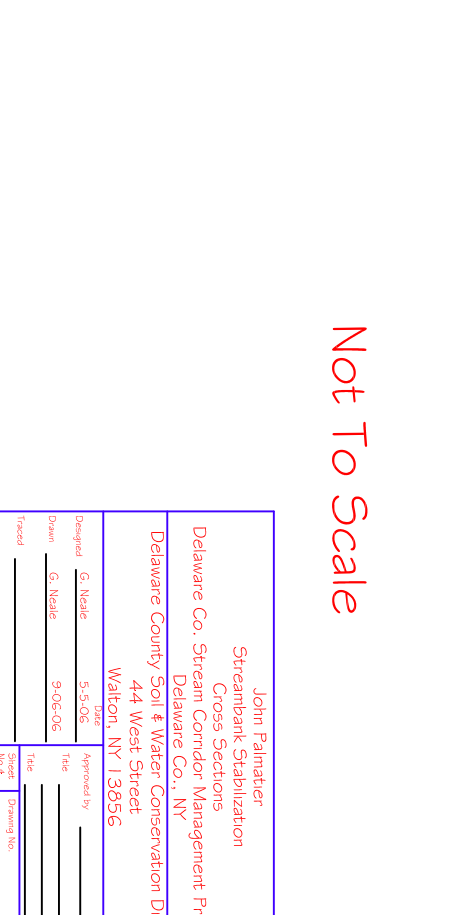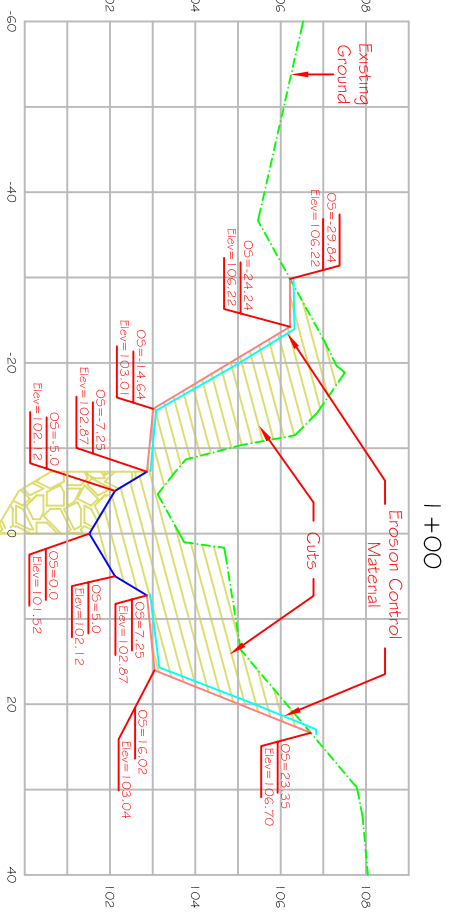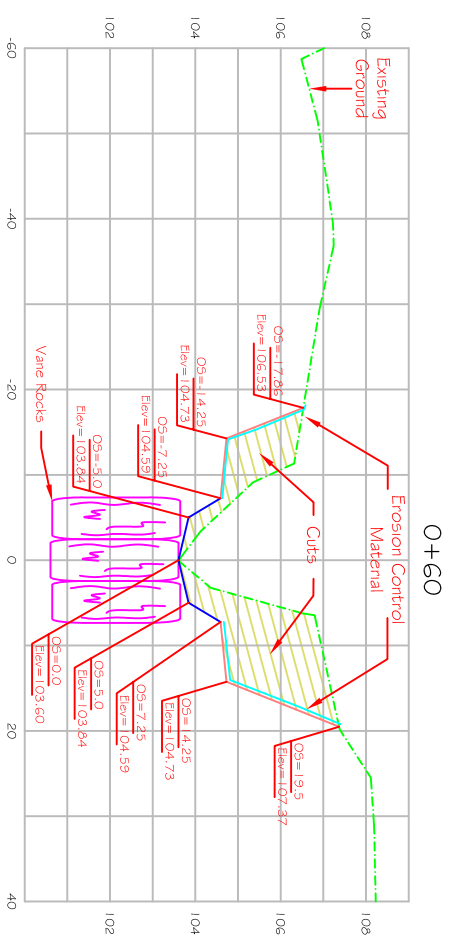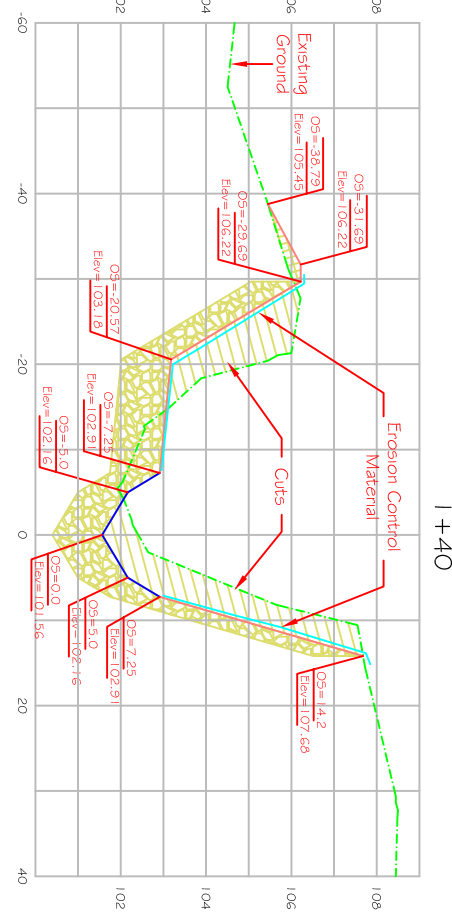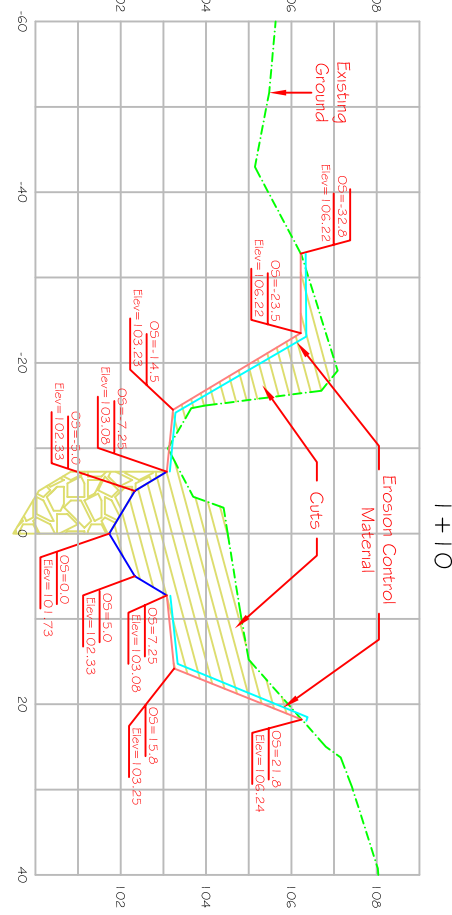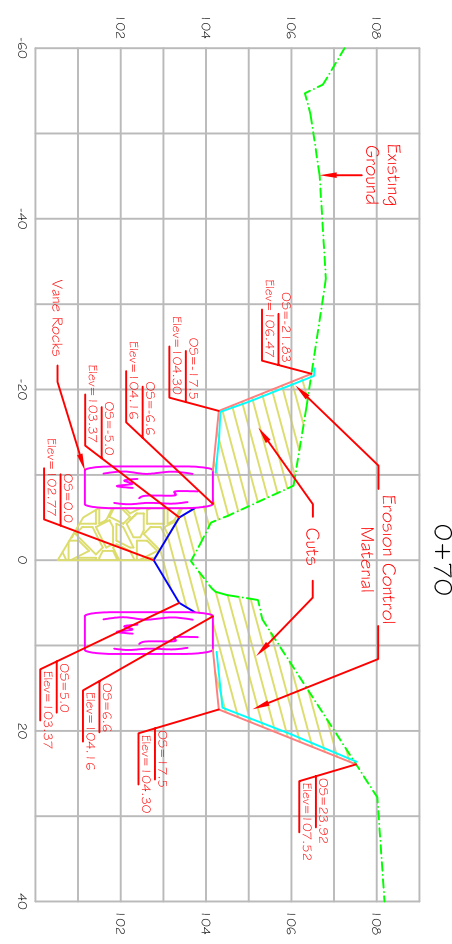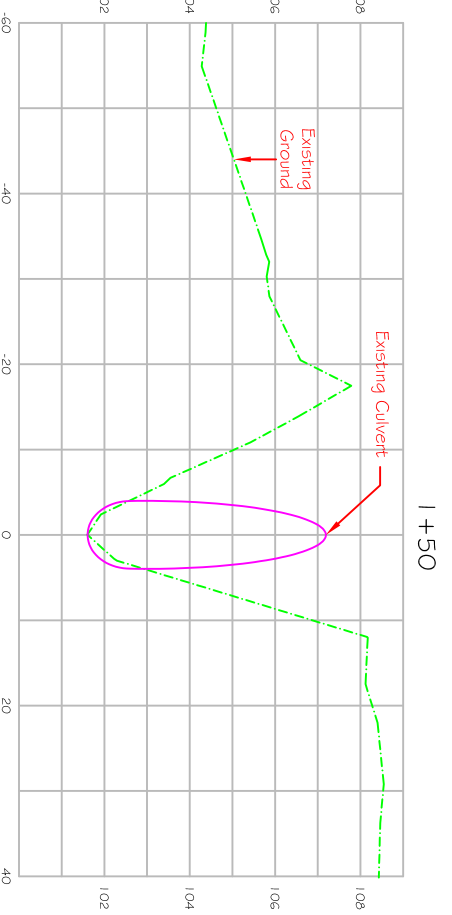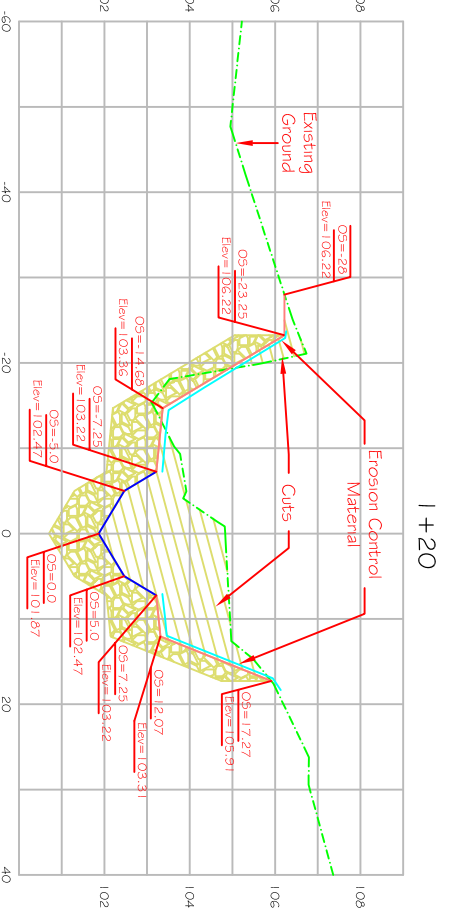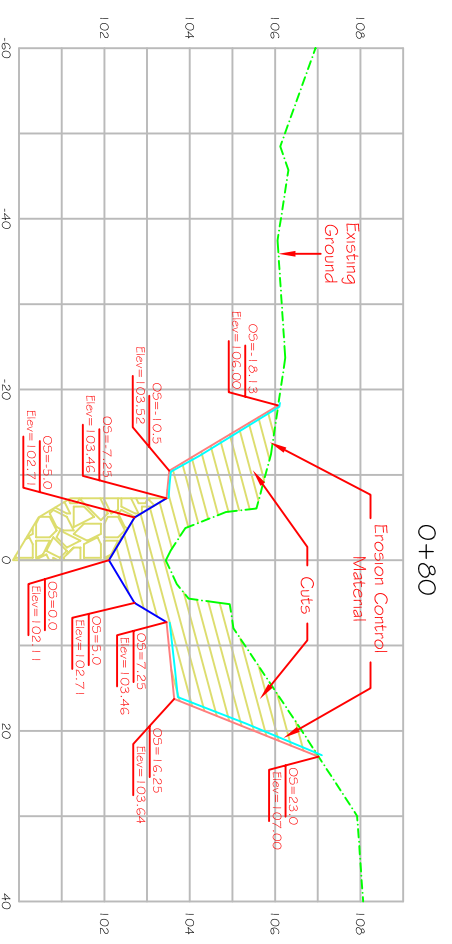


Not To Scale


<p>John Palmater Streambank Stabilization Cross Sections Delaware Co. Stream Corridor Management Program Delaware Co., NY</p>		<p>DF-C-50M/F-009</p>	
<p>Designed: G. Nestle Date: 5-5-06 Drawn: G. Nestle Date: 9-06-06</p>	<p>Approved by: _____ Title: _____</p>	<p>State: N.Y. Scale: _____</p>	<p>Project: 5. Gladstone Date: 9-07-06</p>
<p>Delaware County Soil & Water Conservation District 44 West Street Walton, NY 13856</p>			

Vane Details


Use Schematically for Vane Bar Construction

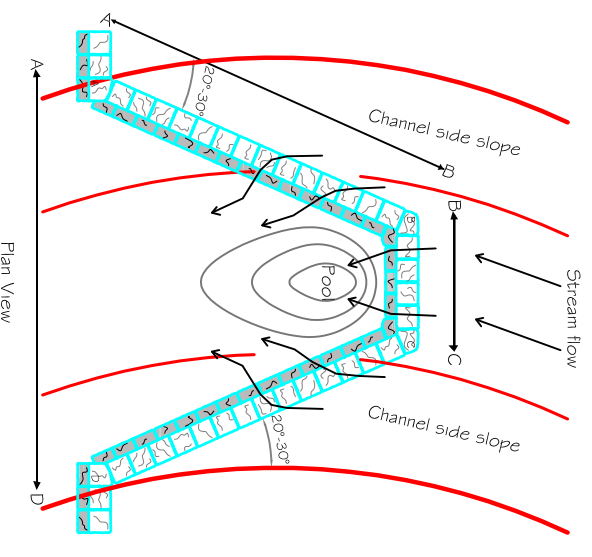


Rip Rap Detail Flood Prone areas and Banks (Not to Scale)

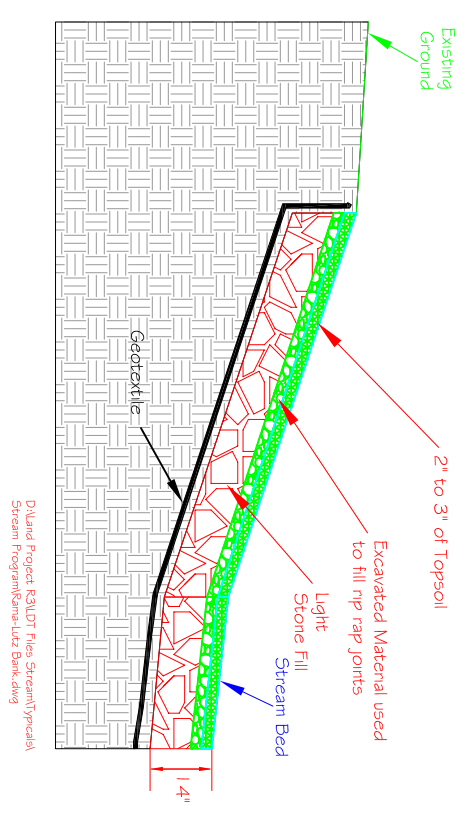


Rip Rap Detail In channel (Not to Scale)

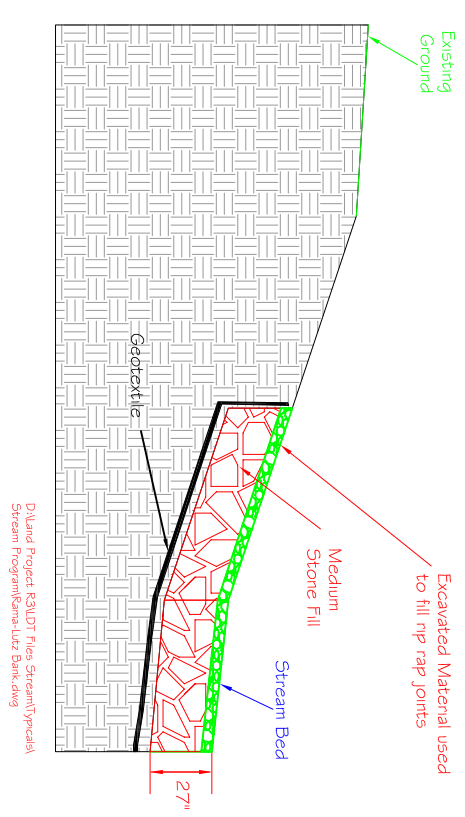

Live Stake Layout (Not to Scale)


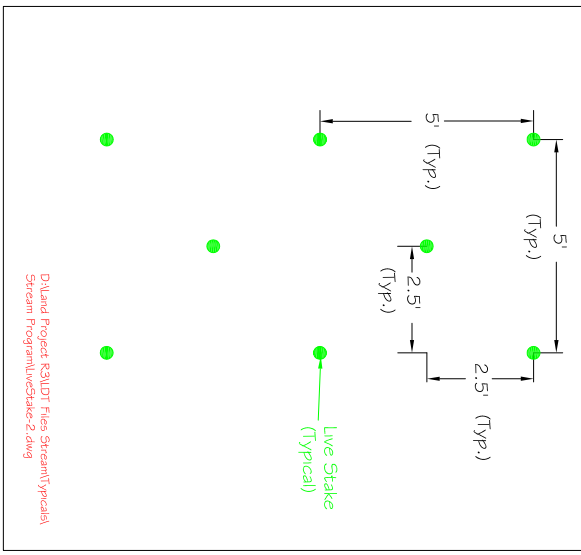


Coffer Dam Detail (Not to Scale)

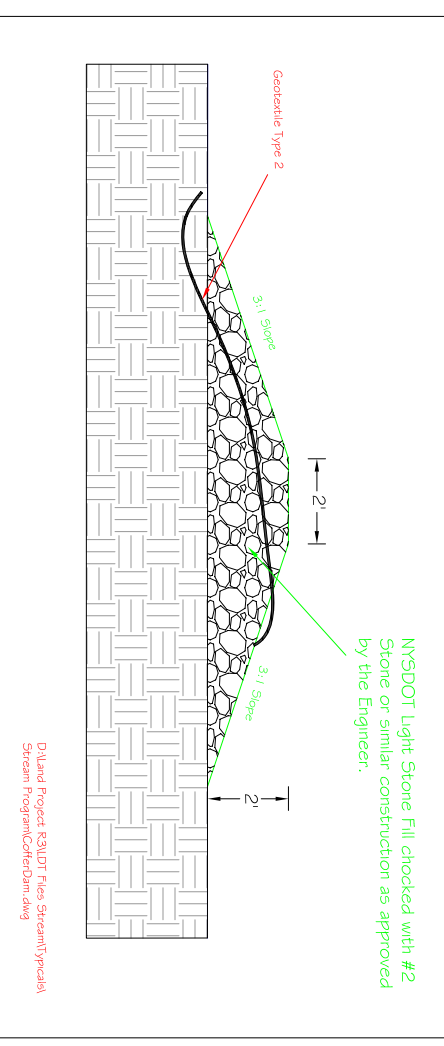


Construction Notes

1. The construction of all structures will be done in the presence of the engineer or his designee.
2. The size and placement of scour holes will be determined by the engineer. See construction specifications.
3. The bank key for all rock structures will be a minimum of seven feet (7') in length, unless otherwise determined by the engineer.

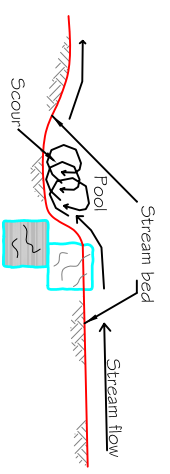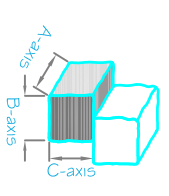

Rock Top/Cofter Detail Section AA Not to scale

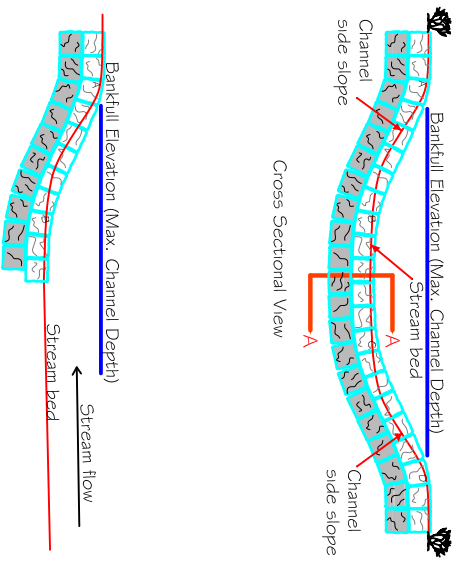

John Palmater StreamBank Stabilization Details	
Delaware Co. Stream Corridor Management Program Delaware Co., NY	
Delaware County Soil & Water Conservation District 44 West Street Walton, NY 13656	
Date Designed <u>G. Niese</u> 5-25-06 Drawn <u>G. Niese</u> 9-06-06	Approved by _____ Title _____ Date _____
Project Created <u>S. Gladstone</u> 9-07-06	Drawing No. DF-C-50MP-009